


\\golder\gds\CAL\IM\CAD\2013\1376\13-1376-0027\2000\2100-REPC\13137600272000C013_NC1_Fig1.dwg | Layout: NC1 | Modified: D:\pikpe 07/17/2015 10:41 AM | Plotted: D:\pikpe 07/17/2015

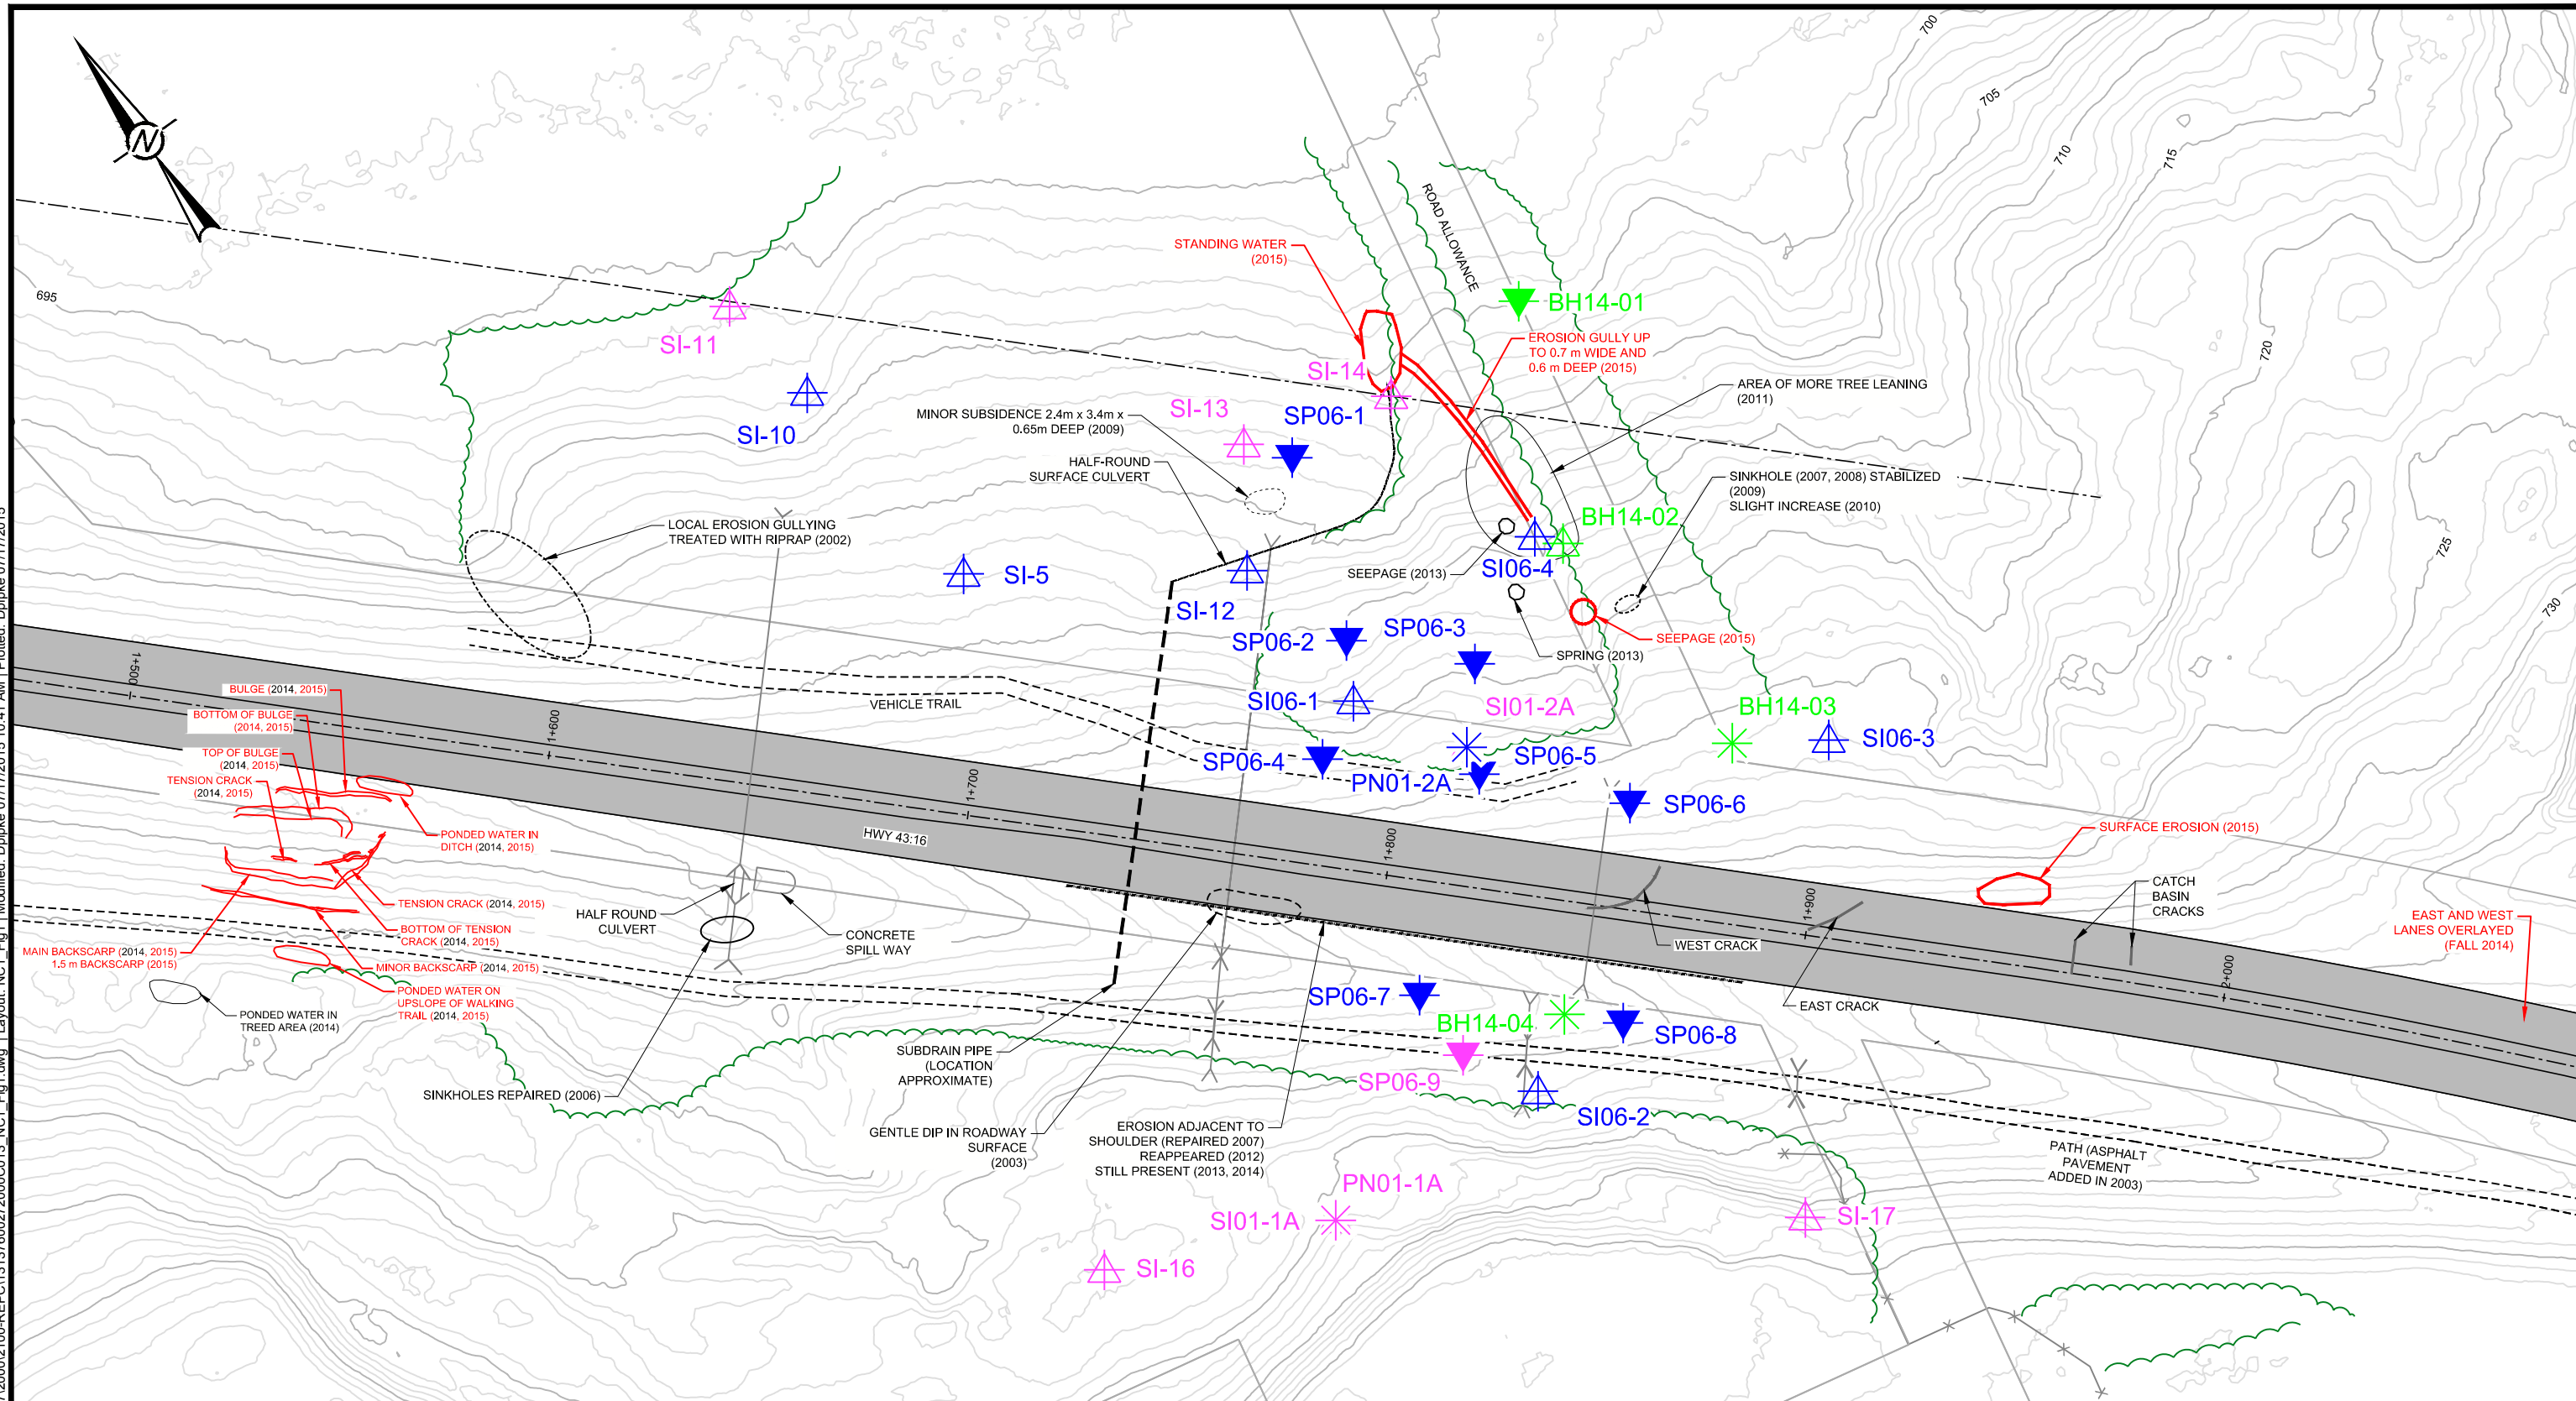

LEGEND	
	SLOPE INCLINOMETERS (ACTIVE)
	SLOPE INCLINOMETERS (IN-ACTIVE)
	SLOPE INCLINOMETERS INSTALLED IN 2014 (ACTIVE)
	STANDPIPE PIEZOMETERS (ACTIVE)
	STANDPIPE PIEZOMETERS (IN-ACTIVE)
	STANDPIPE PIEZOMETERS INSTALLED IN 2014 (ACTIVE)
	PNEUMATIC PIEZOMETERS (ACTIVE)
	PNEUMATIC PIEZOMETERS (IN-ACTIVE)
	PNEUMATIC PIEZOMETERS INSTALLED IN 2014 (ACTIVE)
	TREELINE (APPROXIMATE)

NOTES

1. FEATURE LOCATIONS ARE APPROXIMATE.
2. PREVIOUS OBSERVATIONS SHOWN IN BLACK.
3. 2015 OBSERVATIONS SHOWN IN RED.

DRAFT




REFERENCE
 LIDAR CONTOUR DATA PROVIDED BY ALBERTA TRANSPORTATION SURFACE INFORMATION PROVIDED BY THURBER ENGINEERING
 TRANSVERSE MERCATOR DATUM : NAD83 COORDINATE SYSTEM : UTM_ZONE 1
 PDF OF FIGURE NC1-1A OBTAINED FROM THURBER. PROJECT No.: 15-16-258 DATE: AUGUST 2011 ORIGINAL SCALE: 1:1250


PROJECT		ALBERTA TRANSPORTATION GEOHAZARD MONITORING PROGRAM	
TITLE		NC1 WHITECOURT EAST HILL	
PROJECT No.	13.1376.0027.2000	FILE No.	13137600272000C013
DESIGN	KW 2015-07-13	SCALE	AS SHOWN
CADD	DP 2015-07-13		
CHECK			
REVIEW			

Golder Associates

FIGURE 1

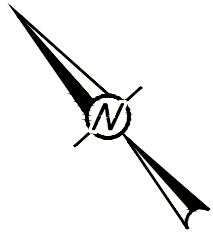

\\golder\gds\CAL\IM\CAD\2013\1376\0027\2000\2100-REPC\13137600272000C014_NC1_Fig2.dwg | Layout: NC1_Fig2.dwg | Modified: D:\p\p\07172015 10:44 AM | Plotted: D:\p\p\07172015

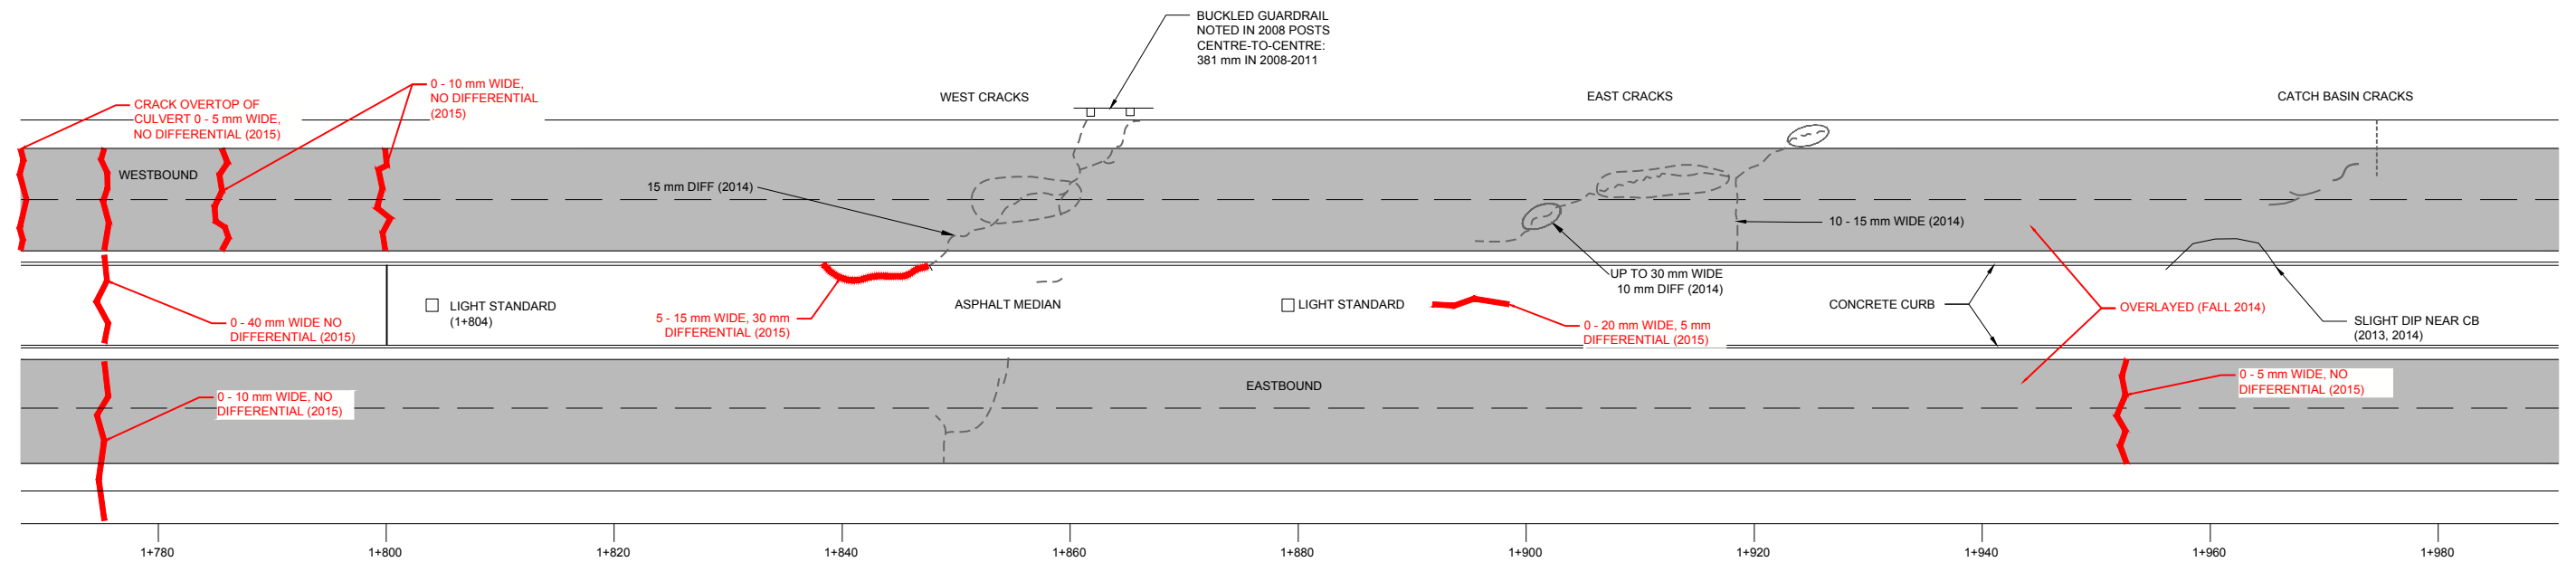

NOTES

1. FEATURE LOCATIONS ARE APPROXIMATE.
2. PREVIOUS OBSERVATIONS SHOWN IN BLACK.
3. 2015 OBSERVATIONS SHOWN IN RED.

REFERENCE

PDF OF FIGURE NC1-2 OBTAINED FROM THURBER. PROJECT No.: 15-16-258
DATE: AUGUST 2011 ORIGINAL SCALE: 1:600

DRAFT



PROJECT				ALBERTA TRANSPORTATION GEOHAZARD MONITORING PROGRAM			
TITLE				NC1 WHITECOURT EAST HILL			
PROJECT No.		13.1376.0027.2000		FILE No.		13137600272000C014	
DESIGN	KW	2015-07-13	SCALE		AS SHOWN		FIGURE 2
CADD	DP	2015-07-13					
CHECK							
REVIEW							

