


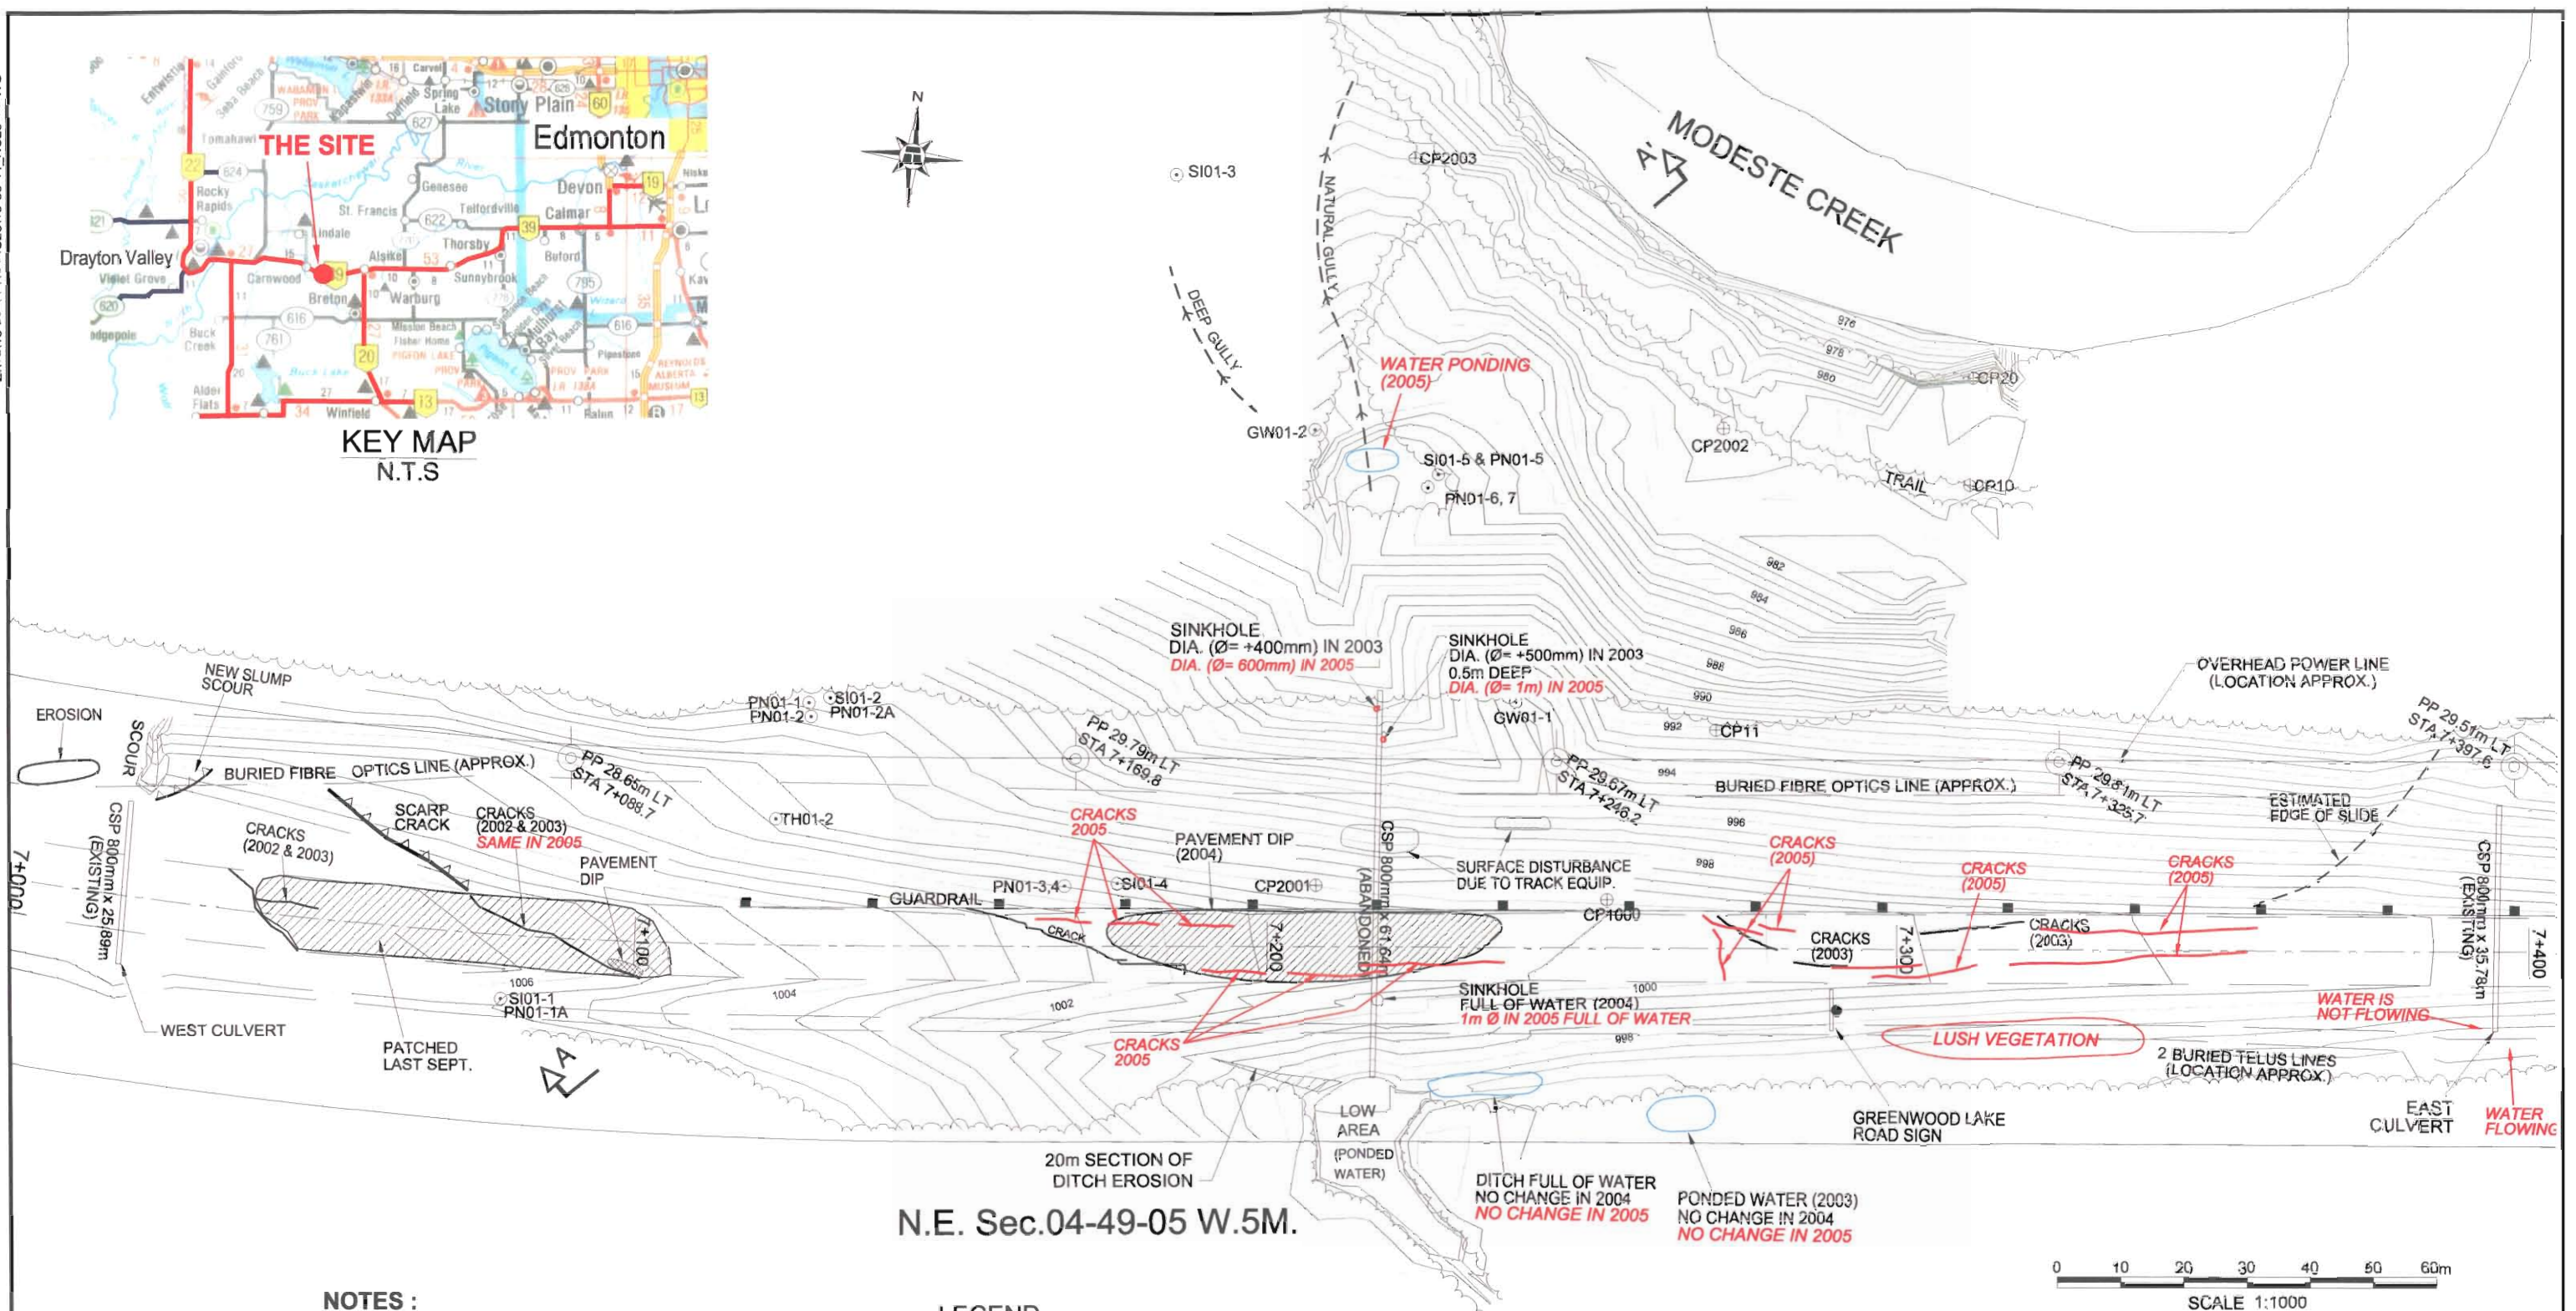

1. FEATURE LOCATIONS ARE APPROXIMATE.
2. PREVIOUS OBSERVATIONS SHOWN IN BLACK
3. MAY 19, 2005 OBSERVATIONS SHOWN IN RED

○ INSTRUMENTATION LOCATION
 SI SLOPE INCLINOMETER
 PN PNEUMATIC PIEZOMETER
 SP STANDPIPE PIEZOMETER
 GW GROUNDWATER MONITORING WELL
 CONTOUR INTERVAL 0.5m

BASE PLAN WAS TAKEN FROM THURBER REPORT #15-76-192

THURBER PROJECT #15-85-11

ALBERTA INFRASTRUCTURE & TRANSPORTATION

SITE PLAN

NORTH CENTRAL 2005
GEOHAZARDS ASSESSMENT

NC23 - HWY 39:06 km 12.6
NE-4-49-5-W5M
GREENWOOD, AB



THURBER ENGINEERING LTD.
GEOTECHNICAL • ENVIRONMENTAL • MATERIALS

ENGINEER:	RVC	DRAWN:	ZD	APPROVED:	
DATE:	MAY 2005	SCALE:	1:1000	DRAWING No.	FIGURE NC23-1

ENGINEER	DRAWN	APPROVED
RVC	ZD	
DATE	SCALE	DRAWING NO.
JULY 2005	1:1000	FIGURE NC23-2