


483350

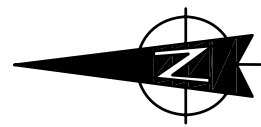

SAG POND AT BASE OF SLIDE HAS SIGNIFICANT WATER IN 2007

SE 20-83-21-5

SOME SEEPAGE

SLIDE 1

3% OVERALL EIGHTS SLOPE

SLIDE 2

FRESH MOVEMENT

SLIDE 3

SLIDE 4

LAYBY

CRACK

6.5 m

6 m

TO GIROUXVILLE

FRESH SCARP

483300

DEVELOPING SCARP

FRESH CRACKING AND VERTICAL OFFSETS


6229250

6229200

6229150

6229100

NOTES:  
 1 LOCATION DATA RECORDED USING HAND HELD GPS RECEIVER. ALL LOCATIONS ARE APPROXIMATE AND ARE FOR ILLUSTRATIVE PURPOSES ONLY.  
 2 2007 OBSERVATIONS SHOWN IN RED

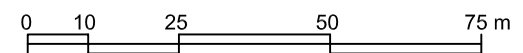

DRAWN BY	ICB	DESIGNED BY		APPROVED BY	
SCALE	1:10250	DATE	JULY 26, 2007	FILE No.	15-85-72-A9A



PEACE REGION (PEACE RIVER/HIGH LEVEL)  
HEART RIVER SLIDES

SITE PLAN

FIGURE 1

