
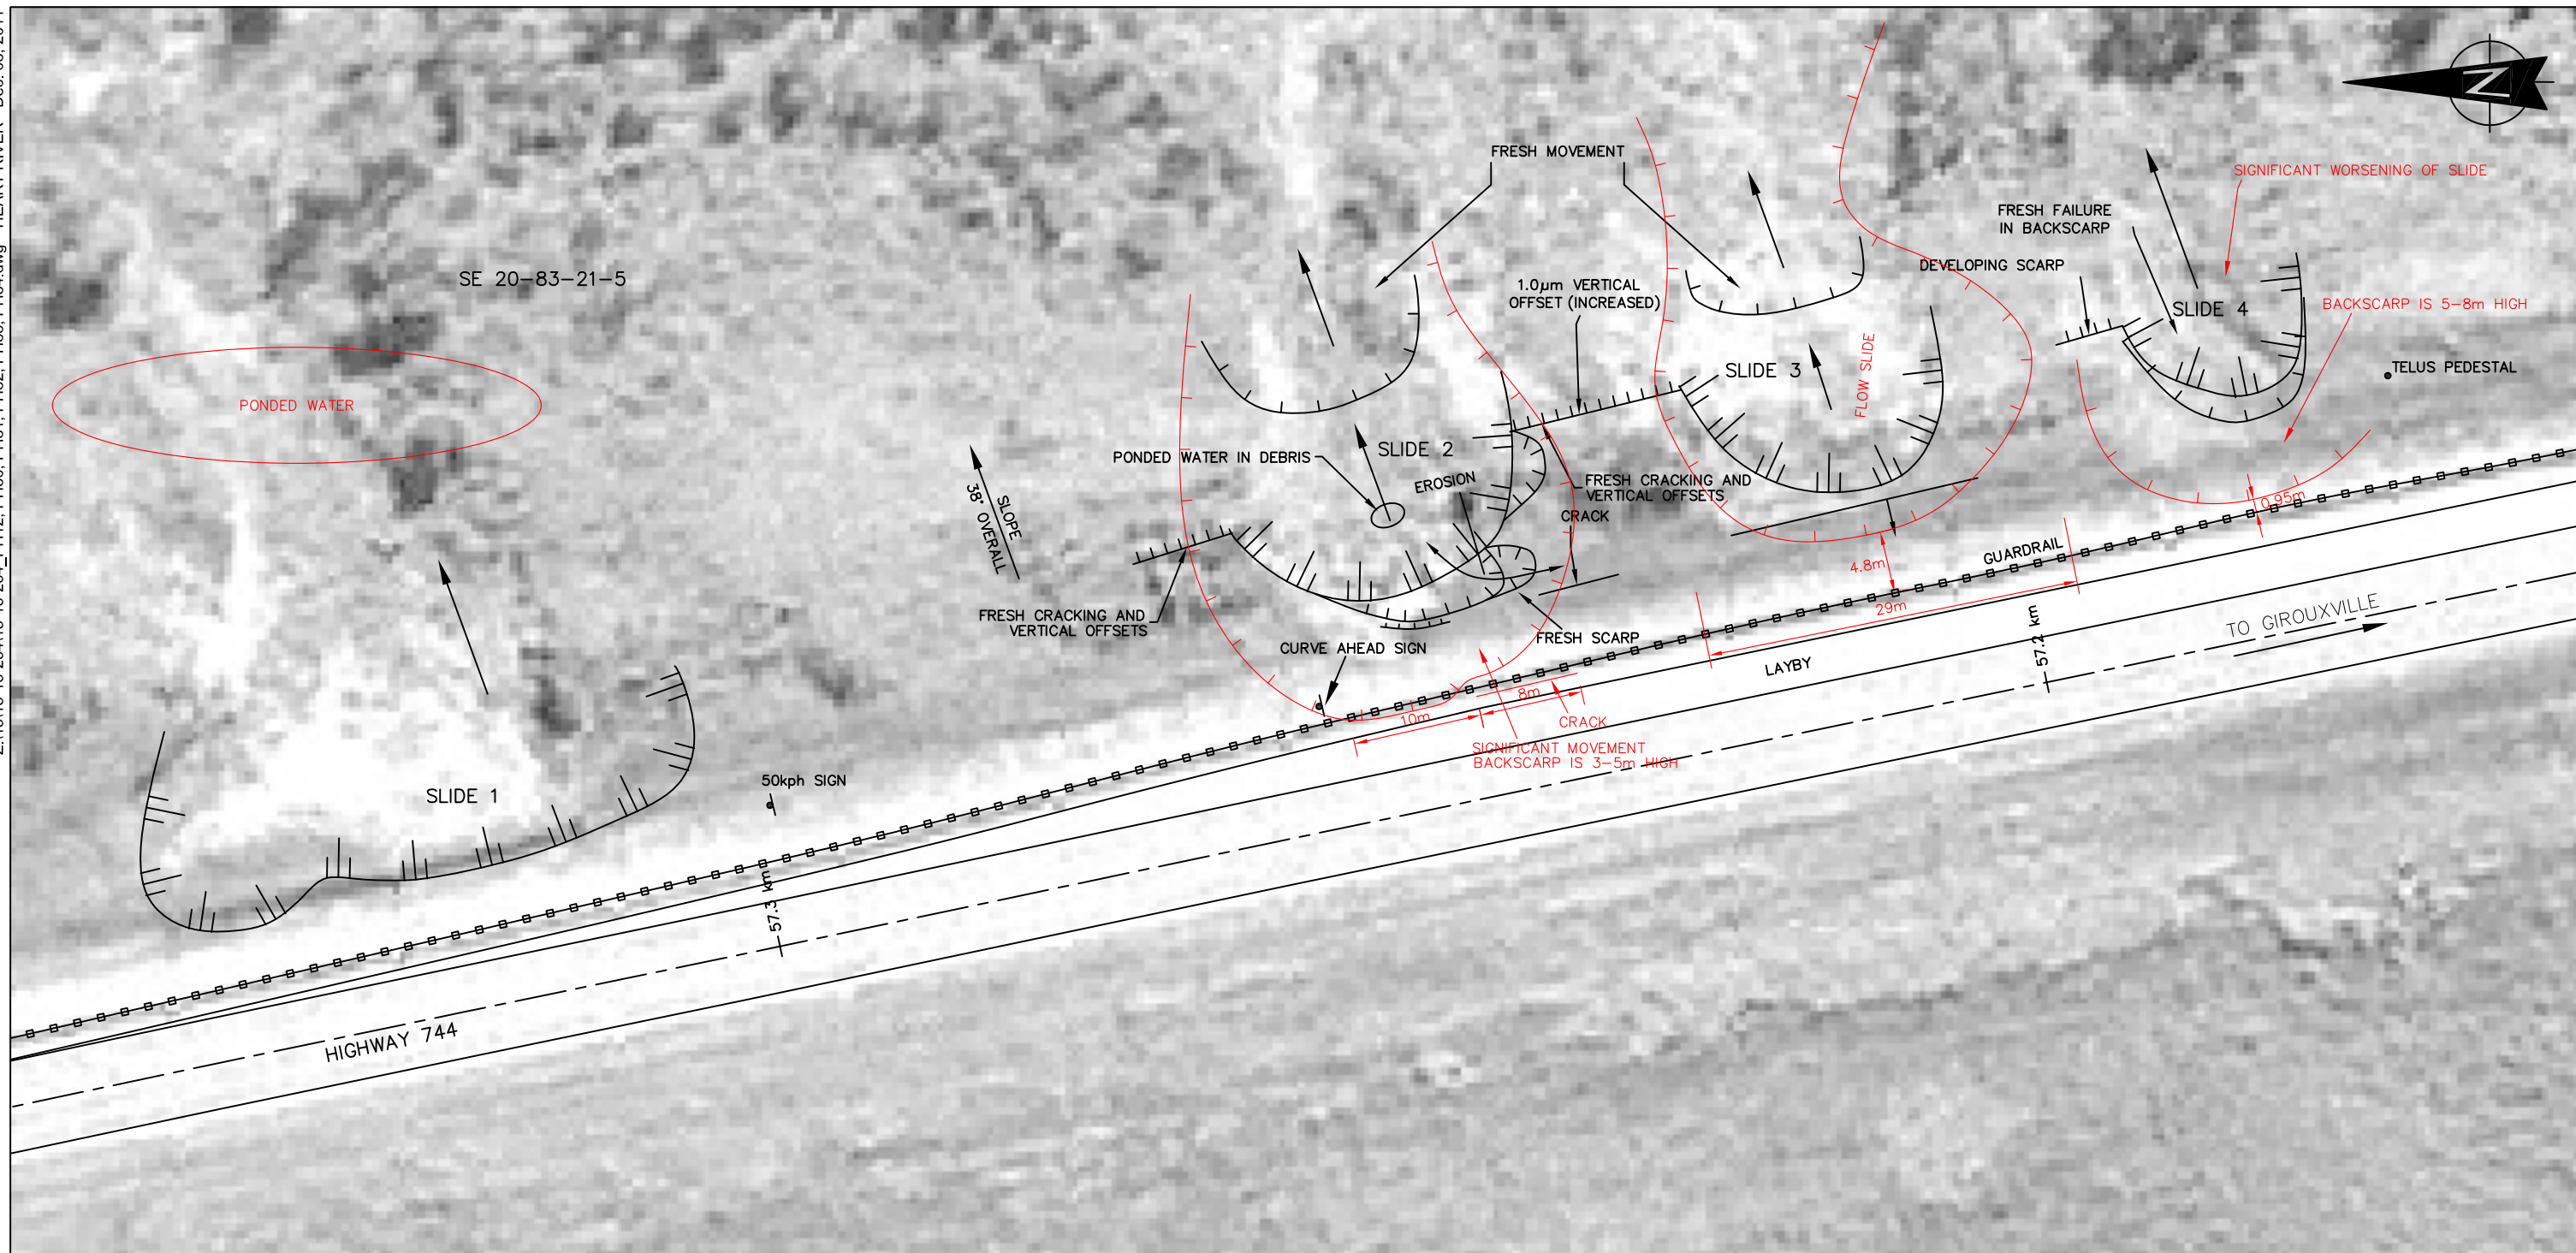


Z:\1515-16-264\15-16-264\_PH12, PH30, PH31, PH32, PH33, PH34.dwg - HEART RIVER - Dec. 08, 2011

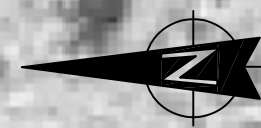

**NOTES:**


- 1 LOCATION DATA RECORDED USING HAND HELD GPS RECEIVER. ALL LOCATIONS ARE APPROXIMATE AND ARE FOR ILLUSTRATIVE PURPOSES ONLY.
- 2 2011 OBSERVATIONS SHOWN IN RED

**Government of Alberta**  
Transportation

PEACE REGION (PEACE RIVER/HIGH LEVEL)  
PH12 HEART RIVER SLIDES

**SITE PLAN**

**FIGURE 1**

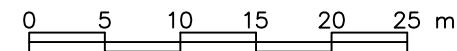

DRAWN BY	ICB/HH	DESIGNED BY	SGR	APPROVED BY	DWP
SCALE	1:500	DATE	JUNE 2011	FILE No.	15-16-264

