


- NOTES:**
1. ADAPTED FROM DECEMBER 2008 AS-CONSTRUCTED DRAWING, ALBERTA TRANSPORTATION TENDER CE067/07, AMEC PROJECT NO. CG25264.
 2. SURVEY BY MEASUREMENT SCIENCES INC., APRIL 2007, APPROXIMATE DISCHARGE WAS 3.8 m³/s AT TIME OF SURVEY.
 3. TOPOGRAPHIC CONTOUR INTERVAL FOR LANDSLIDE AREA IS 1m FOR MAJOR CONTOURS AND 0.5m FOR MINOR CONTOURS.
 4. PHOTOS S4-1 TO S4-11 REFER TO JUNE 2009 PHOTOS (SEE REPORT).

	Designed By:	AB	Project: WILLOW CREEK STREAMBANK PROTECTION AND LANDSLIDE REPAIR	Project No.:	CG25309.B	
	Drawn By:	JC		CADD File:	25309N28.dwg	
Client: 	Checked By:		Title:		Date:	JULY 2009
	Approved By:	AB	SITE PLAN			
	Scale:	AS SHOWN				
			Drawing No.: FIGURE 1 Sheet No.:			

I:\CG25309\25309N28.dwg - FIGURE 1 - Jul 31, 2009 8:58am - shahjibrah

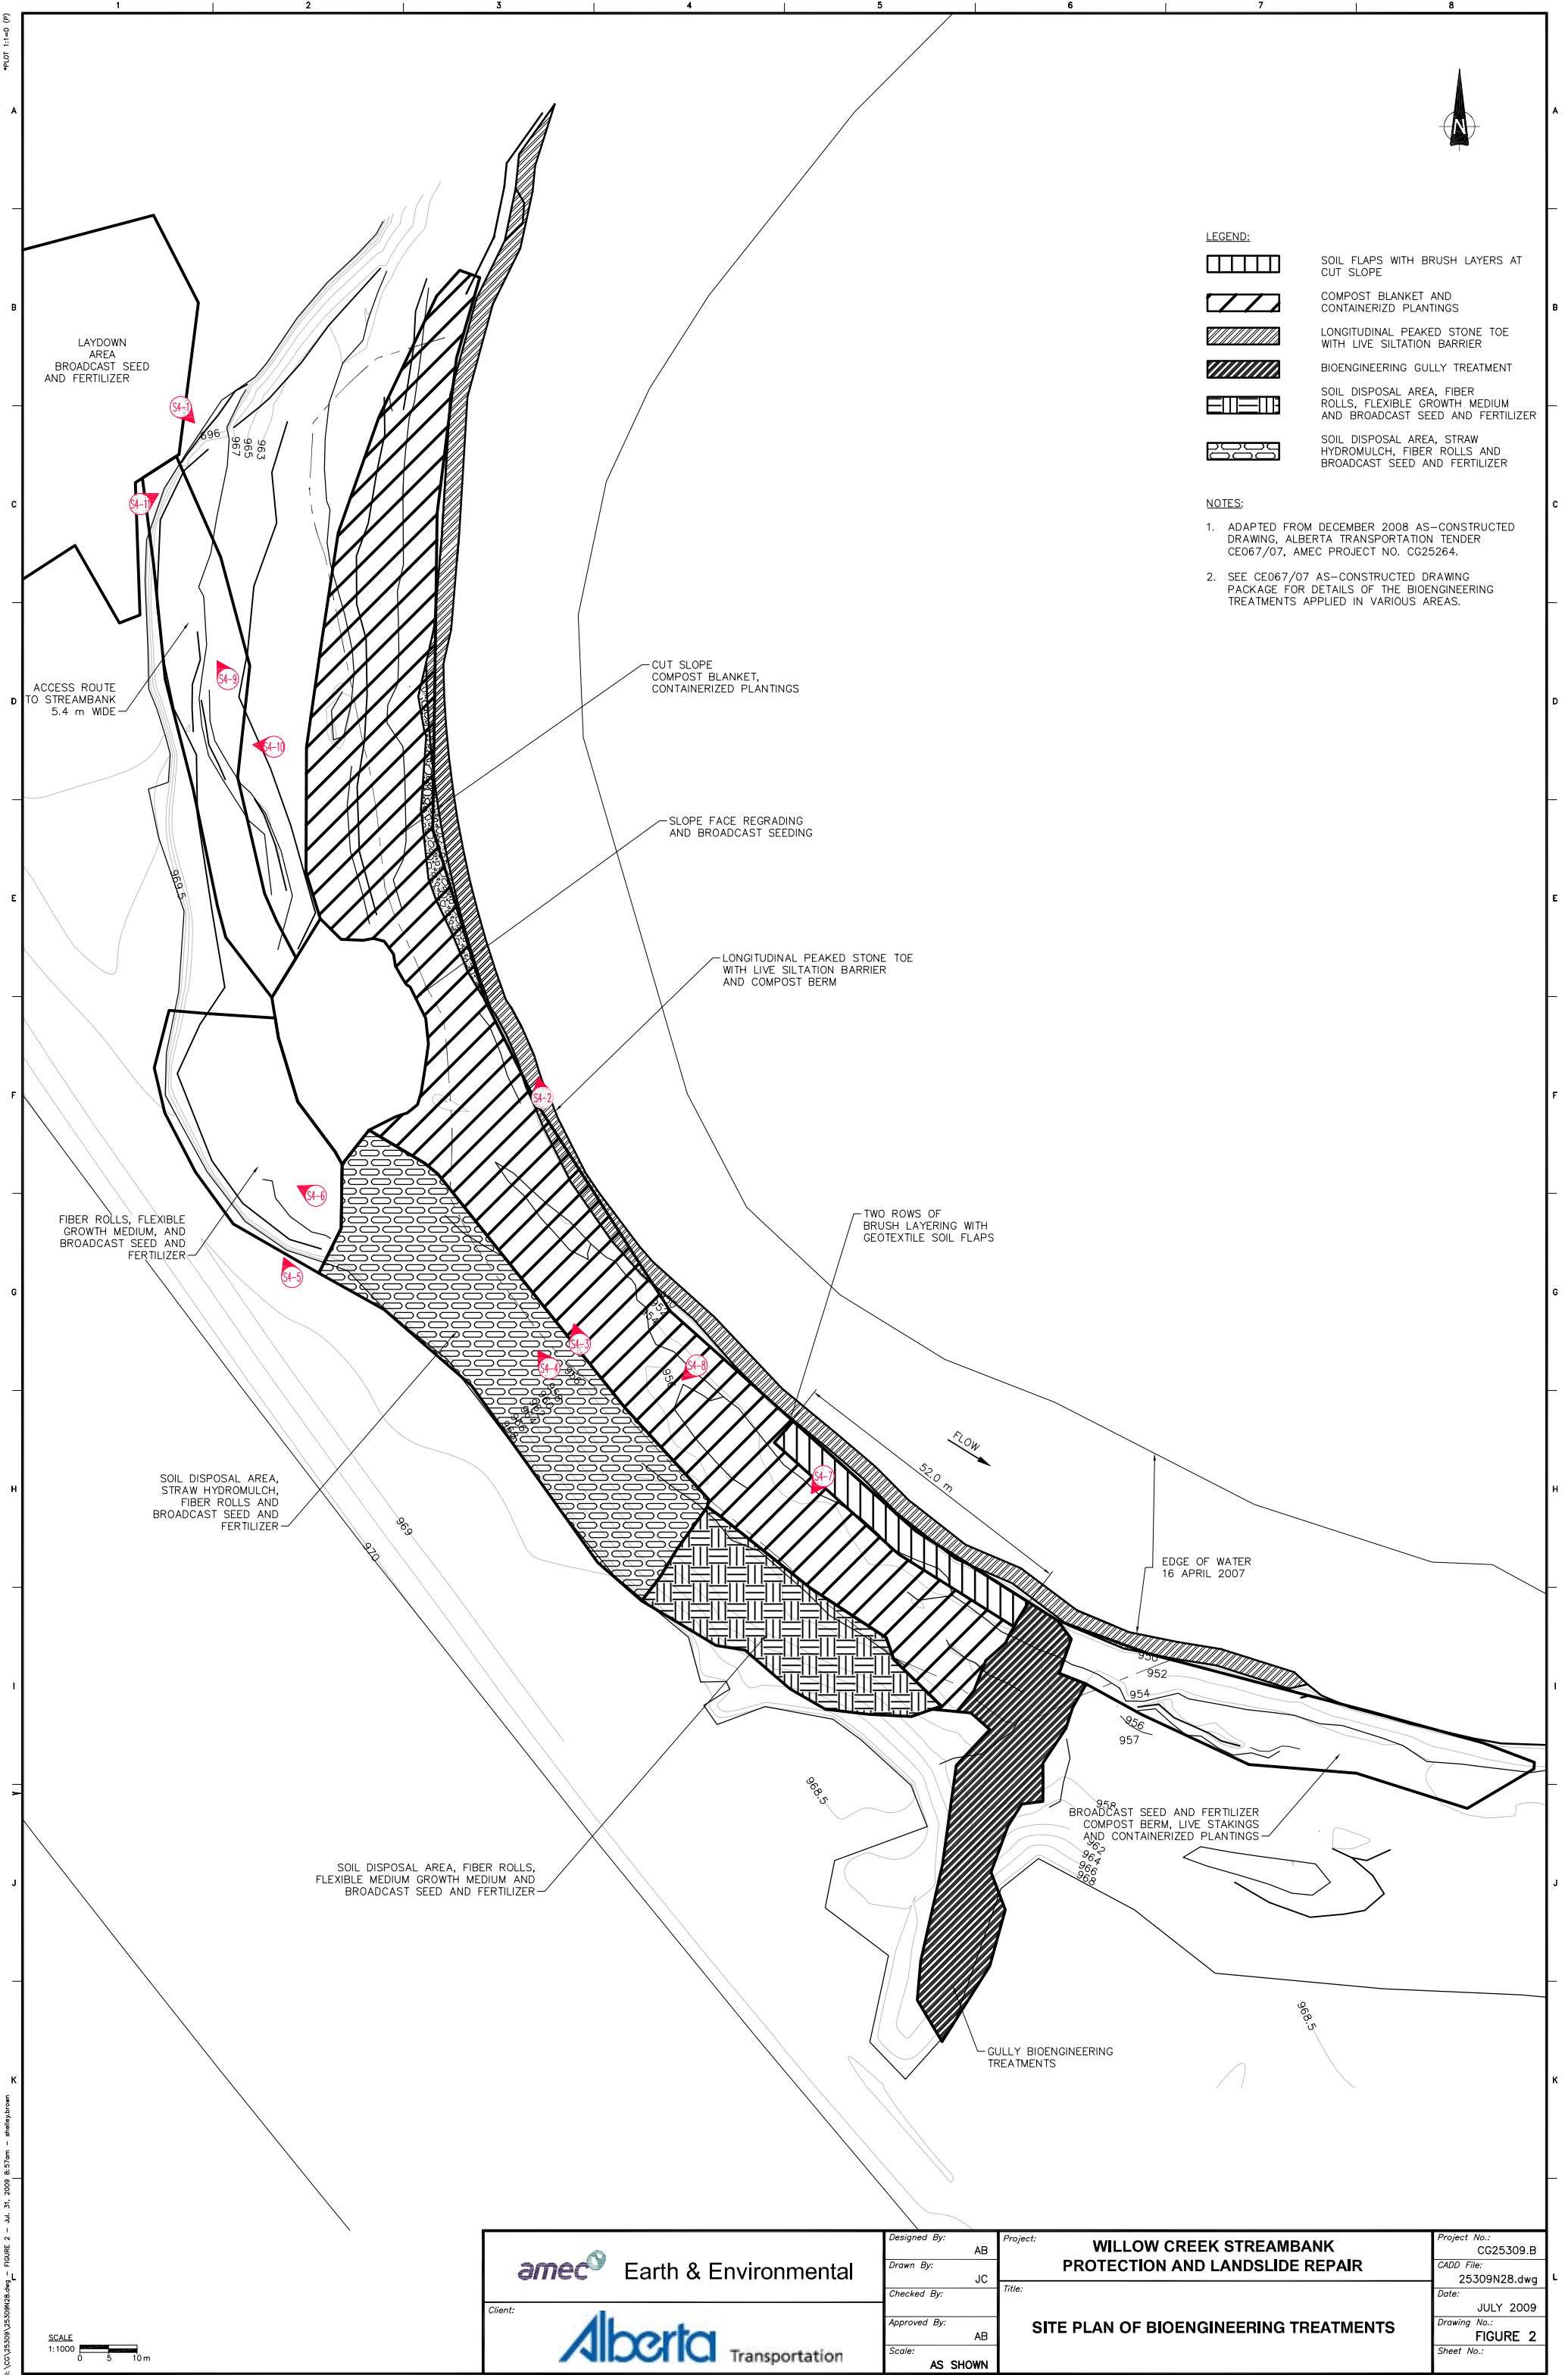

	Designed By:	AB	Project: WILLOW CREEK STREAMBANK PROTECTION AND LANDSLIDE REPAIR	Project No.:	CG25309.B
	Drawn By:	JC		CADD File:	25309N28.dwg
	Checked By:	AB	Title: SITE PLAN OF BIOENGINEERING TREATMENTS	Date:	JULY 2009
	Approved By:	AB		Drawing No.:	FIGURE 2
	Scale:	AS SHOWN		Sheet No.:	

I:\CG\25309\25309N28.dwg - FIGURE 2 - Jul 31, 2009 8:57am - wshelph@amec