


NOTES:

- 1. ADAPTED FROM DECEMBER 2008 AS-CONSTRUCTED DRAWING, ALBERTA TRANSPORTATION TENDER CE067/07, AMEC PROJECT NO. CG25264.
- 2. SURVEY BY MEASUREMENT SCIENCES INC., APRIL 2007, APPROXIMATE DISCHARGE WAS 3.8 m³/s AT TIME OF SURVEY.
- 3. TOPOGRAPHIC CONTOUR INTERVAL FOR LANDSLIDE AREA IS 1m FOR MAJOR CONTOURS AND 0.5m FOR MINOR CONTOURS.
- 4. PHOTOS S4-1 TO S4-11 REFER TO JUNE 2009 PHOTOS (SEE REPORT).

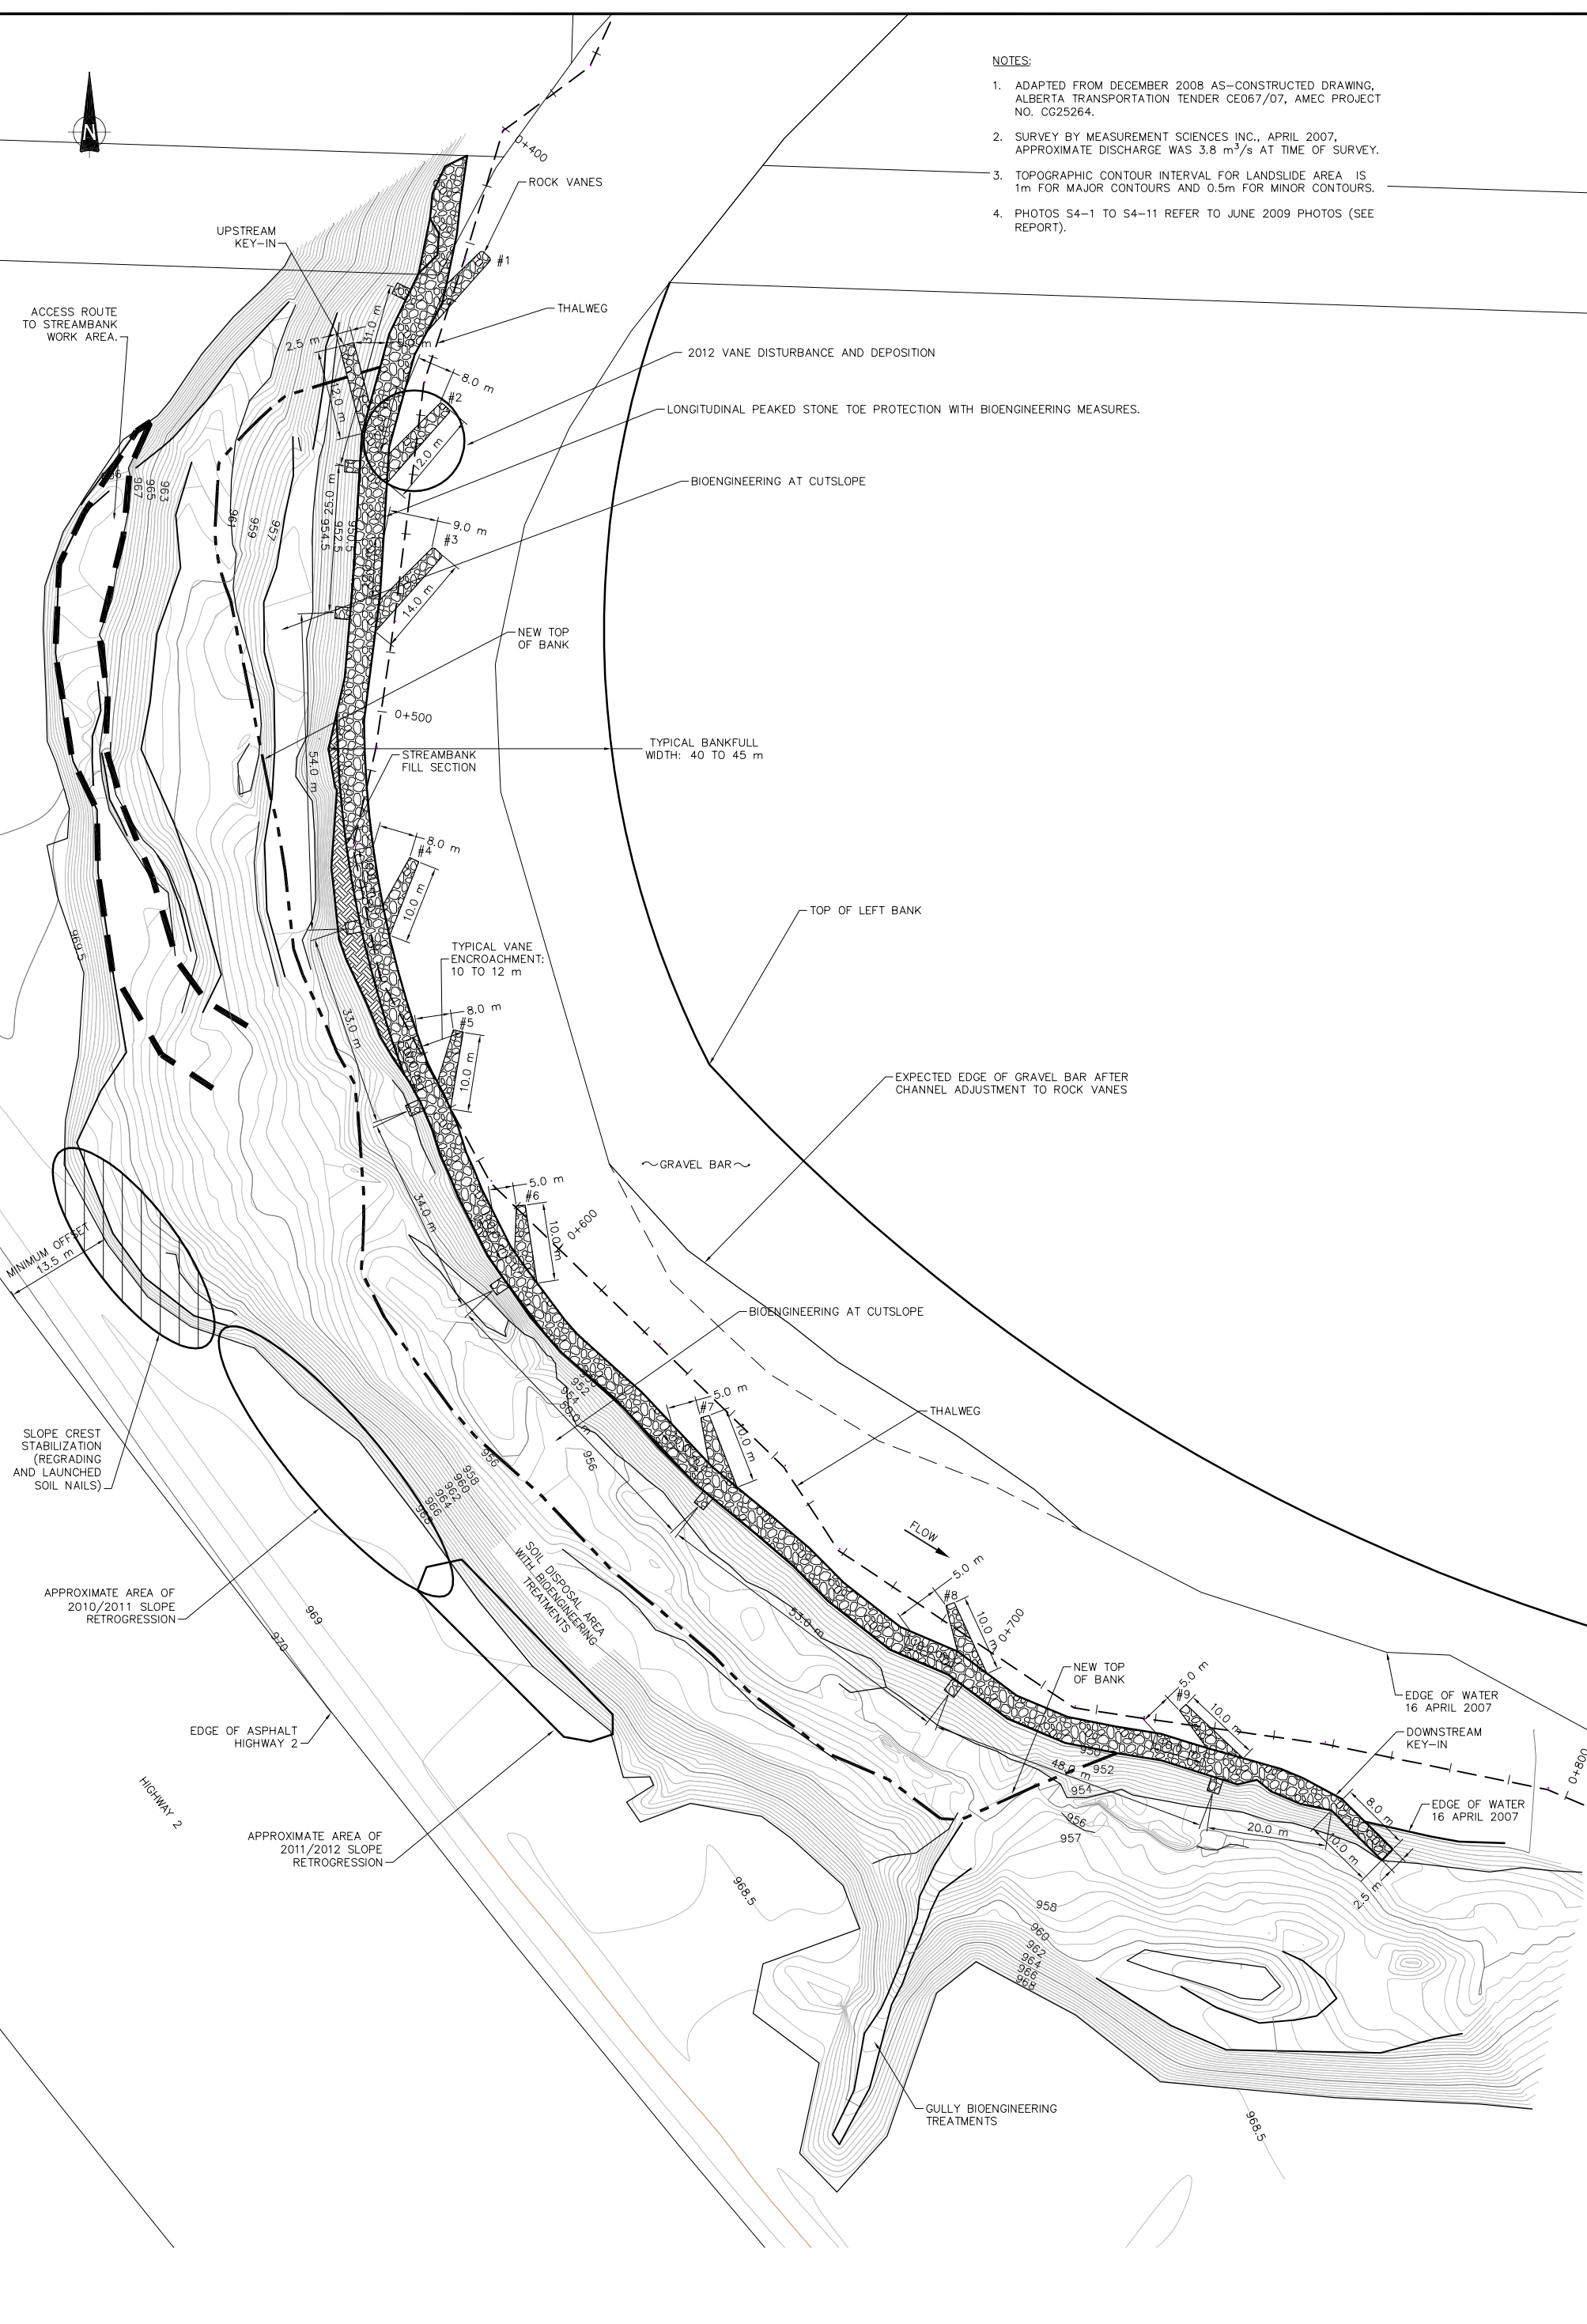

SCALE 1:1000





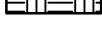
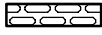
CLIENT:




PROJECT: SOUTHERN REGION GEOHAZARD ASSESSMENT 2013 ANNUAL INSPECTIONS				
TITLE: SITE S4 - HIGHWAY 2:08, WILLOW CREEK SITE PLAN				
DATE: DECEMBER 2013	JOB No.: CG25399.200	CAD FILE: 25399H02.dwg	FIGURE No.: FIGURE S4-1	REV. A

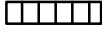


LEGEND:



-  SOIL FLAPS WITH BRUSH LAYERS AT CUT SLOPE
-  COMPOST BLANKET AND CONTAINERIZED PLANTINGS
-  LONGITUDINAL PEAKED STONE TOE WITH LIVE SILTATION BARRIER
-  BIOENGINEERING GULLY TREATMENT
-  SOIL DISPOSAL AREA, FIBER ROLLS, FLEXIBLE GROWTH MEDIUM AND BROADCAST SEED AND FERTILIZER
-  SOIL DISPOSAL AREA, STRAW HYDROMULCH, FIBER ROLLS AND BROADCAST SEED AND FERTILIZER

NOTES:

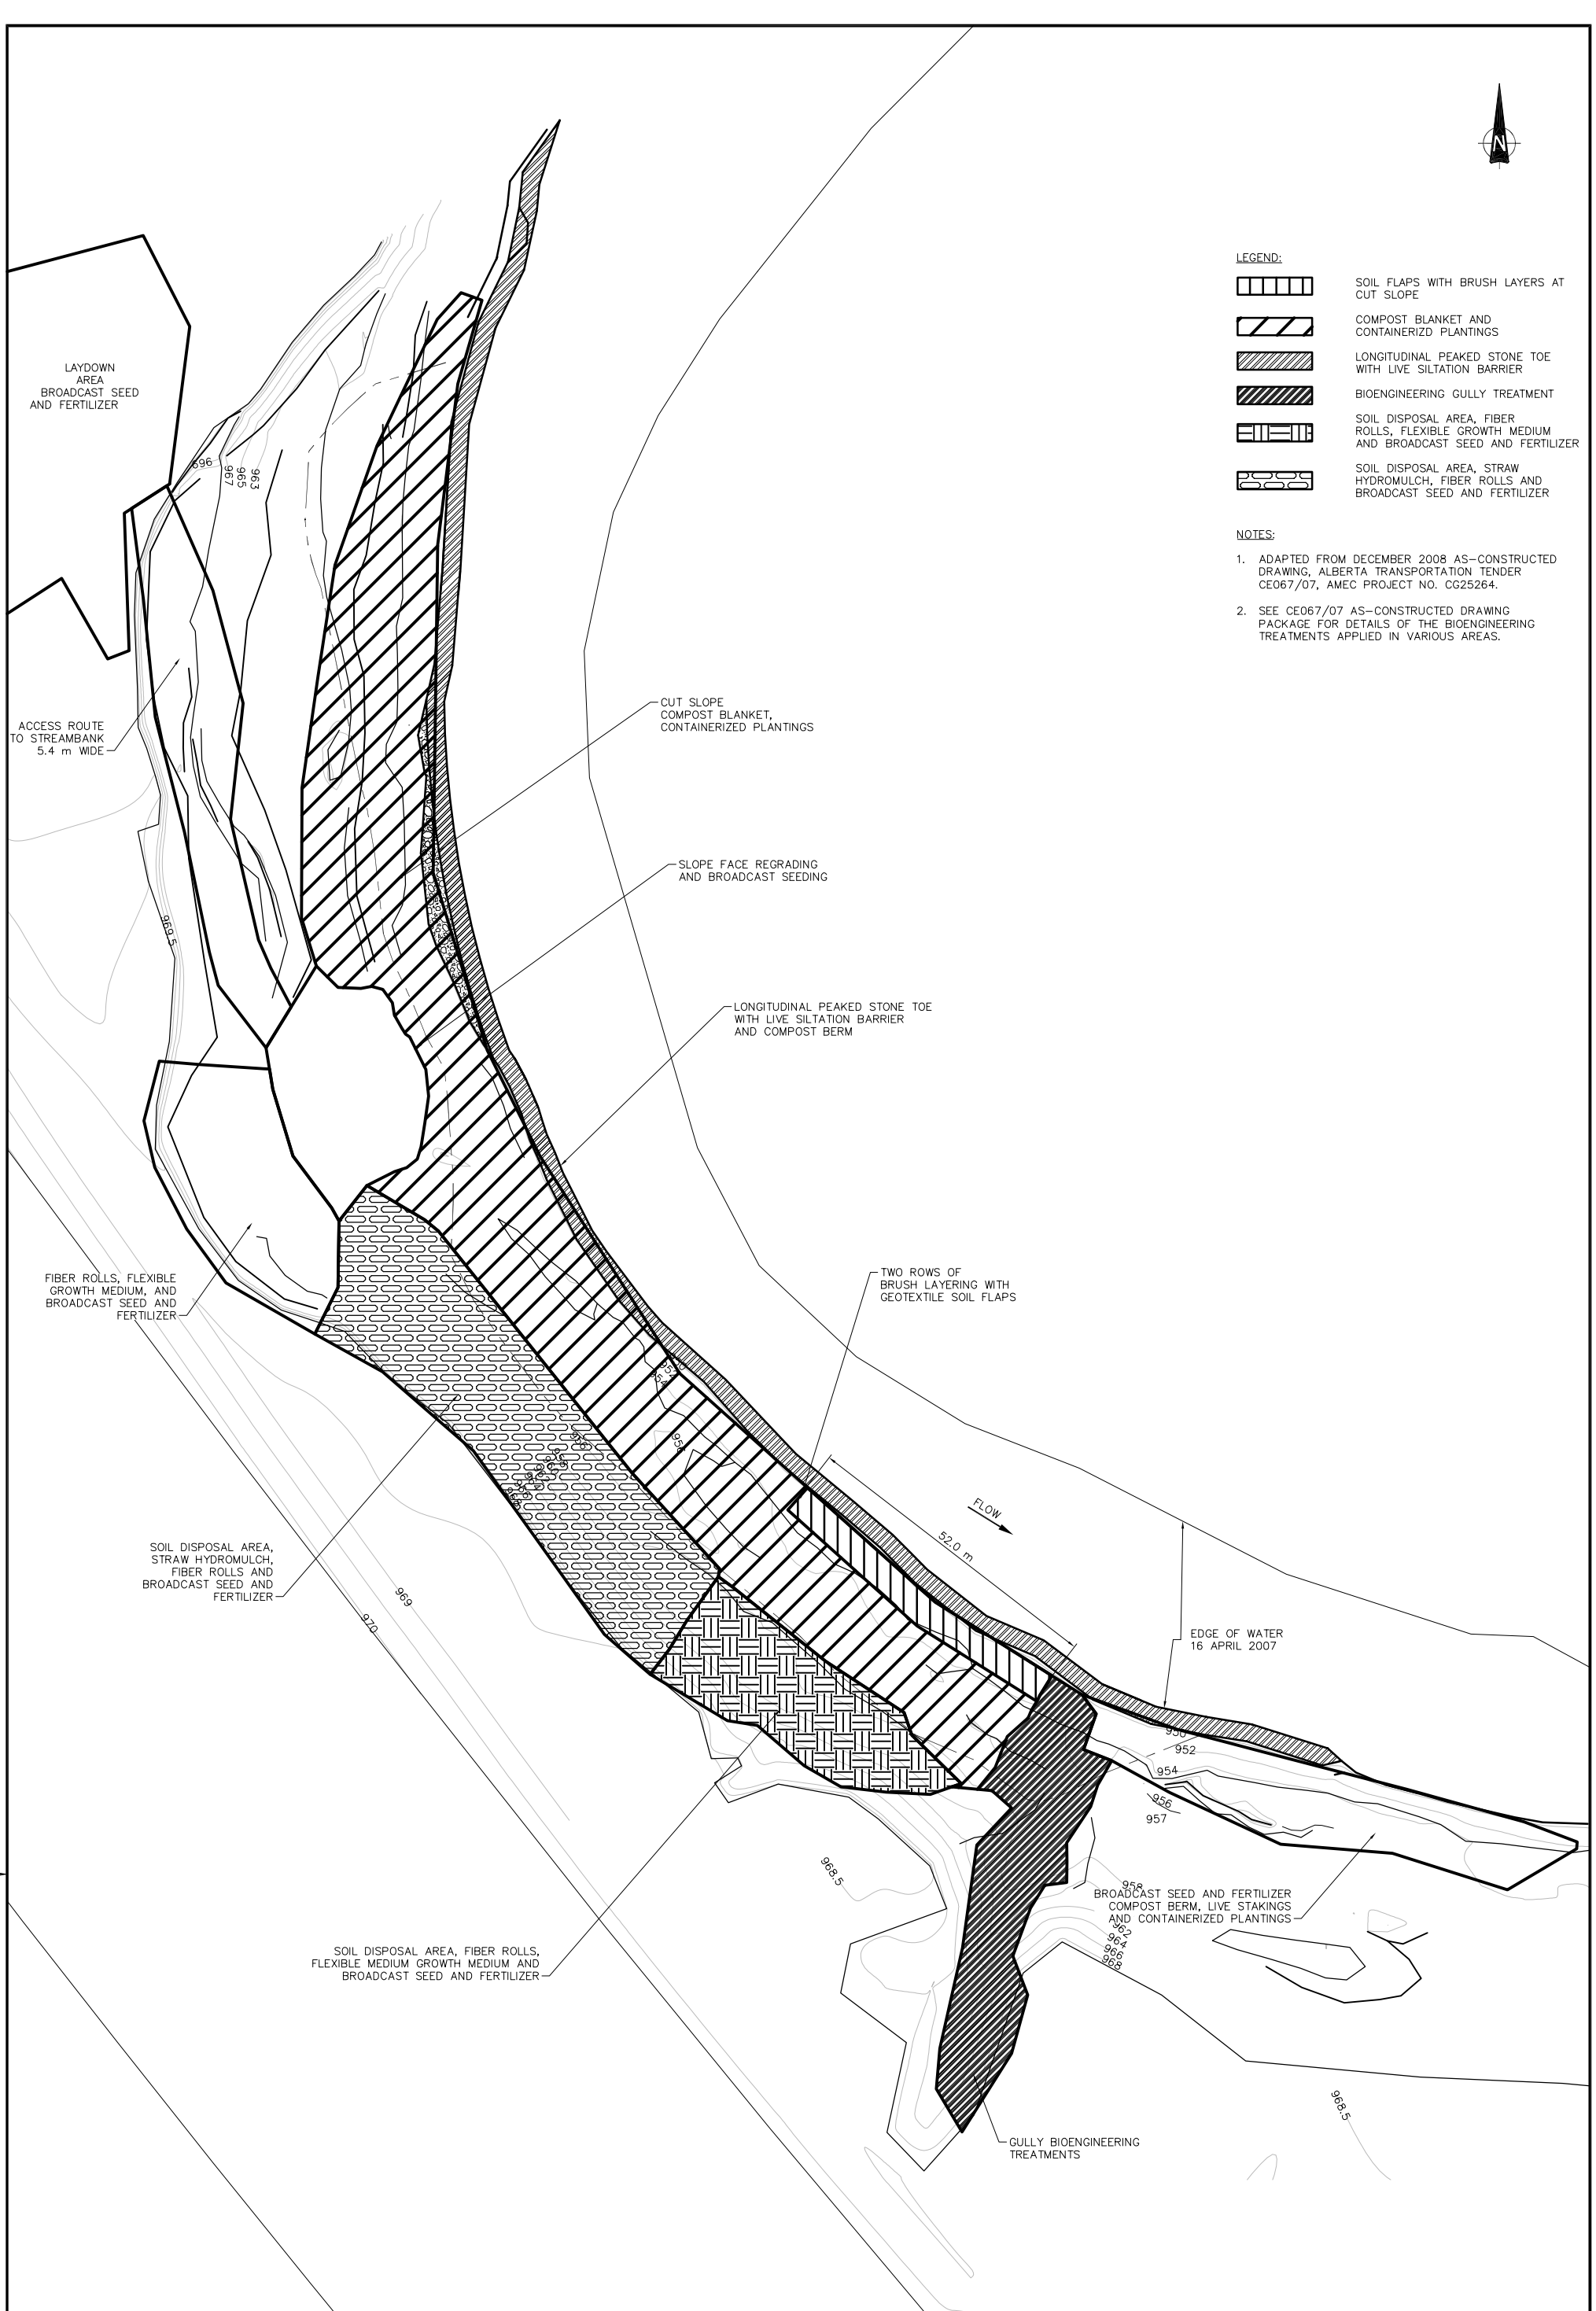1. ADAPTED FROM DECEMBER 2008 AS-CONSTRUCTED DRAWING, ALBERTA TRANSPORTATION TENDER CE067/07, AMEC PROJECT NO. CG25264.
2. SEE CE067/07 AS-CONSTRUCTED DRAWING PACKAGE FOR DETAILS OF THE BIOENGINEERING TREATMENTS APPLIED IN VARIOUS AREAS.



SCALE
1:1000
0 5 10m

 	PROJECT: SOUTHERN REGION GEOHAZARD ASSESSMENT 2013 ANNUAL INSPECTIONS				
	TITLE: SITE S4 - HIGHWAY 2:08, WILLOW CREEK SITE PLAN				
CLIENT:	DATE: DECEMBER 2013	JOB No.: CG25399.200	CAD FILE: 25399H02.dwg	FIGURE No.: FIGURE S4-2	REV. A

I:\CO\25399\25399H02.dwg - FIGURE S4-2 - Dec. 20, 2013 5:15pm - mcor/husohil