


SCALE 1:1000 (APPROX.)

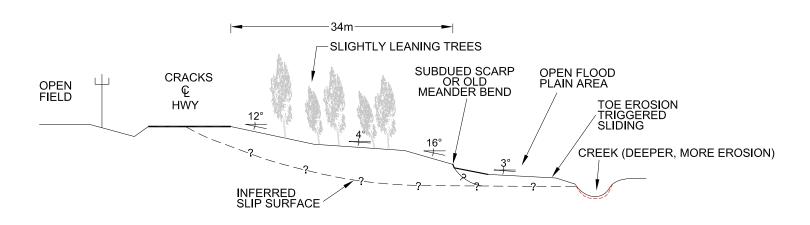

OVERTURNED TREE

## SECTION A - A'

## **NOTES:**

- 1. FEATURE LOCATIONS ARE APPROXIMATE
- 2. PREVIOUS OBSERVATIONS SHOWN IN BLACK
- 3. AUGUST 2, 2011 OBSERVATIONS SHOWN IN RED

## **LEGEND:**

- TELUS PEDESTAL
- PROPOSED SI AND PZ LOCATION
- → PROPOSED PZ LOCATION
- 1 PHOTO AND DIRECTION

FIGURE PH47-1 CALLOUT DEADWOOD SLIDE- PH47 - HWY 690:02 PEACE REGION (PEACE RIVER/HIGH LEVEL) GEOHAZARD ASSESSMENTS

DATE: AUGUST 2, 2011

