

**ALBERTA TRANSPORTATION
GEOHAZARD ASSESSMENT PROGRAM
PEACE REGION – SWAN HILLS
2020 INSPECTION**



Site Number	Location	Name	Hwy	km
SH024-12 SH024-12B* SH024-12A* SH024-12D**	Little Smoky River	Little Smoky River Valley, North Hill – Sites #12, #12B, #12A, and #12D	744:02	20.80-20.90 20.94-21.03 21.03-21.12 21.17-21.30
Legal Description		UTM Co-ordinates		
Site 12: NE21-76-22-W5M		11U E 478,432	N	6,162,375
Site 12B: NE21-76-22-W5M		11U E 478,472	N	6,162,492
Site 12A: NE21-76-22-W5M		11U E 478,504	N	6,162,588
Site 12D: NE21- and SE28-76-22-W5M		11U E 478,550	N	6,162,737

	Date	PF	CF	Total
Previous Inspection:	12-Jun-2019	9	3	27
Current Inspection:	3-Jun-2020	9	3	27
Road AADT:	240		Year:	2020
Inspected By:	Rocky Wang, TRANS		Ken Froese, Thurber	
Report Attachments:	<input checked="" type="checkbox"/> Photographs <input checked="" type="checkbox"/> Plans <input type="checkbox"/> Maintenance Items			

Primary Site Issue:	Highway traverses deep-seated, retrogressive landslides with ongoing creep movements due partly to erosion at toe by the Little Smoky River and Peavine Creek resulting in cracking and sagging of the pavement surface at numerous locations. Approx. 4 km of the highway crosses this unstable north valley slope. These Sites are 55 m to 60 m above and 375 m to 475 m away from the Peavine Creek.		
Dimensions:	Site 12: 95 m length of highway affected by cracking and guardrail distortion. Site 12B: 65 m length of highway with cracking. Site 12A: 90 m length of highway with cracking. * In 2016, a review of historical documentation for this Site determined that Site #12C should be #12B (south portion) and #12A (north portion). ** Site #12D not assessed since 2015.		
Date of Remediation:	2002: Site #12A subexcavated and reconstructed with pitrun gravel with 2 m high toe berm, subdrain installation, and culvert extension. 2003: Site #12A: culvert lined with 762 mm smooth-wall steel 2004: Site #12 subexcavated and replaced with pitrun gravel with clay toe berm and subdrain; west ditch erosion also repaired.		
Maintenance:	Routine ACP crack sealing, milling, and patching, when required. 2019: Milling over most of the sites 2020: Line painting		
Observations (Site 12):	Description	Worsened?	
<input checked="" type="checkbox"/> Pavement Distress	Vertical distortion over historical scarp crack and associated cracking.	<input checked="" type="checkbox"/>	
<input checked="" type="checkbox"/> Slope Movement	Site is located on an active deep-seated landslide moving toward the Peavine Creek. There is vertical and horizontal distortion of the guardrail.	<input checked="" type="checkbox"/>	

<input type="checkbox"/> Erosion		<input type="checkbox"/>
<input type="checkbox"/> Seepage		<input type="checkbox"/>
<input type="checkbox"/> Bridge/Culvert Distress		<input type="checkbox"/>
<input type="checkbox"/> Other		<input type="checkbox"/>
Observations (Site 12B):	Description	Worsened?
<input checked="" type="checkbox"/> Pavement Distress	Scarp crack visible through patching.	<input checked="" type="checkbox"/>
<input checked="" type="checkbox"/> Slope Movement	Site is located on an active deep-seated landslide moving toward the Peavine Creek.	<input checked="" type="checkbox"/>
<input type="checkbox"/> Erosion		<input type="checkbox"/>
<input type="checkbox"/> Seepage		<input type="checkbox"/>
<input type="checkbox"/> Bridge/Culvert Distress		<input type="checkbox"/>
<input type="checkbox"/> Other		<input type="checkbox"/>
Observations (Site 12A):	Description	Worsened?
<input checked="" type="checkbox"/> Pavement Distress	Some longitudinal and traverse cracking which may not be related to slope movement.	<input checked="" type="checkbox"/>
<input checked="" type="checkbox"/> Slope Movement	Site is located on an active deep-seated landslide moving toward the Peavine Creek. The toe berm appears to be functioning to stabilize the local embankment.	<input type="checkbox"/>
<input checked="" type="checkbox"/> Erosion	Minor erosion along grassed-lined channel at culvert outlet (km 21.081).	<input type="checkbox"/>
<input type="checkbox"/> Seepage		<input type="checkbox"/>
<input checked="" type="checkbox"/> Bridge/Culvert Distress	Culvert at km 21.081: outlet of SWSP liner is rusting.	<input type="checkbox"/>
<input type="checkbox"/> Other		<input type="checkbox"/>
Instrumentation:		
None.		
Assessment:		
<p>The overall valley slope is moving as several separate slide blocks in response to the toe erosion and downcutting of two different rivers resulting in numerous scarps, sag ponds, and differential movement zones going in slightly different directions. The highway intersects the scarps of these blocks at several locations resulting in an uneven highway surface and cracking.</p> <p>Site 12: The main slide scarp crack was visible at the Township Road 764 (TR764) intersection and the site required milling in 2019 to remove the growing vertical differential. The main crack was also patched afterward. The vertical differential and crack development continued to deteriorate despite the recent maintenance. In 2020, there appeared to be a slight sag in the highway surface just south of the TR764 intersection. The south 2/3's of the guardrail appears to be leaning downslope and vertical deflection of the rail was noted across from the TR764 intersection. Overall, the toe berm appears to be functioning to stabilize the highway fill embankment; however, it is not conclusive if the pavement cracking and guardrail deformation is related to the local or global slope movements. A potential scarp</p>		

feature was identified on the sideslope of the highway embankment just north of the toe berm but was not apparent in 2020.

Site 12B:

This site, an area of additional cracking between the two toe berms at Site #12 and Site #12A, was discontinued from the GeoHazard Assessment program in 2007. At the time of the 2016 inspection, there appeared to be a long crack roughly parallel to the highway that may be associated with slope movement and the width and extents of cracking have increased slightly each year following. The recent milling appears to have exposed previously-covered cracks and there does appear to be an arc-shape to the pattern. The crack widths are on the order of 10 mm to 20 mm with some areas up to 30 mm. Some of the cracks are braided with overall widths up to 500 mm and at least had a slight dip over the width of the braided cracks.

Site 12A:

There is some longitudinal and transverse cracking along the highway above the toe berm; however, it was not apparent if this was related to subgrade issues or slope movement. The site was milled in 2019 which has exposed additional cracks. There was continued deterioration observed in 2020. Two zones of seepage were noted in the downslope ditch which may be subdrain outlets. It appears that the toe berm has been successful in stabilizing the local highway embankment at this location.

Recommendations:

Short-Term:

- Road maintenance should continue as necessary to maintain a safe roadway surface and may consist of milling, patching, and crack sealing of the ACP.


Long-Term:

It is understood that, at this time, the only long-term remediation option under consideration is realignment of the entire north hill section of Highway 744. However, given the high cost of this option and as it is a low volume highway, it is unlikely that realignment will be undertaken in the near future. Consideration is also being given to a shorter realignment which would include Site #12 and potentially a portion of Site #12B. Site #12A would not be included in this shorter realignment option.

Ongoing Investigation:

- It is recommended that the annual GeoHazard inspection should continue as scheduled.

H:\13000\13355 Geohazard Assessment - Swan Hills (CON0017604)\Drafting\2020\KEY\13355 SH024-12.dwg - Layout1 - Oct. 23, 2020

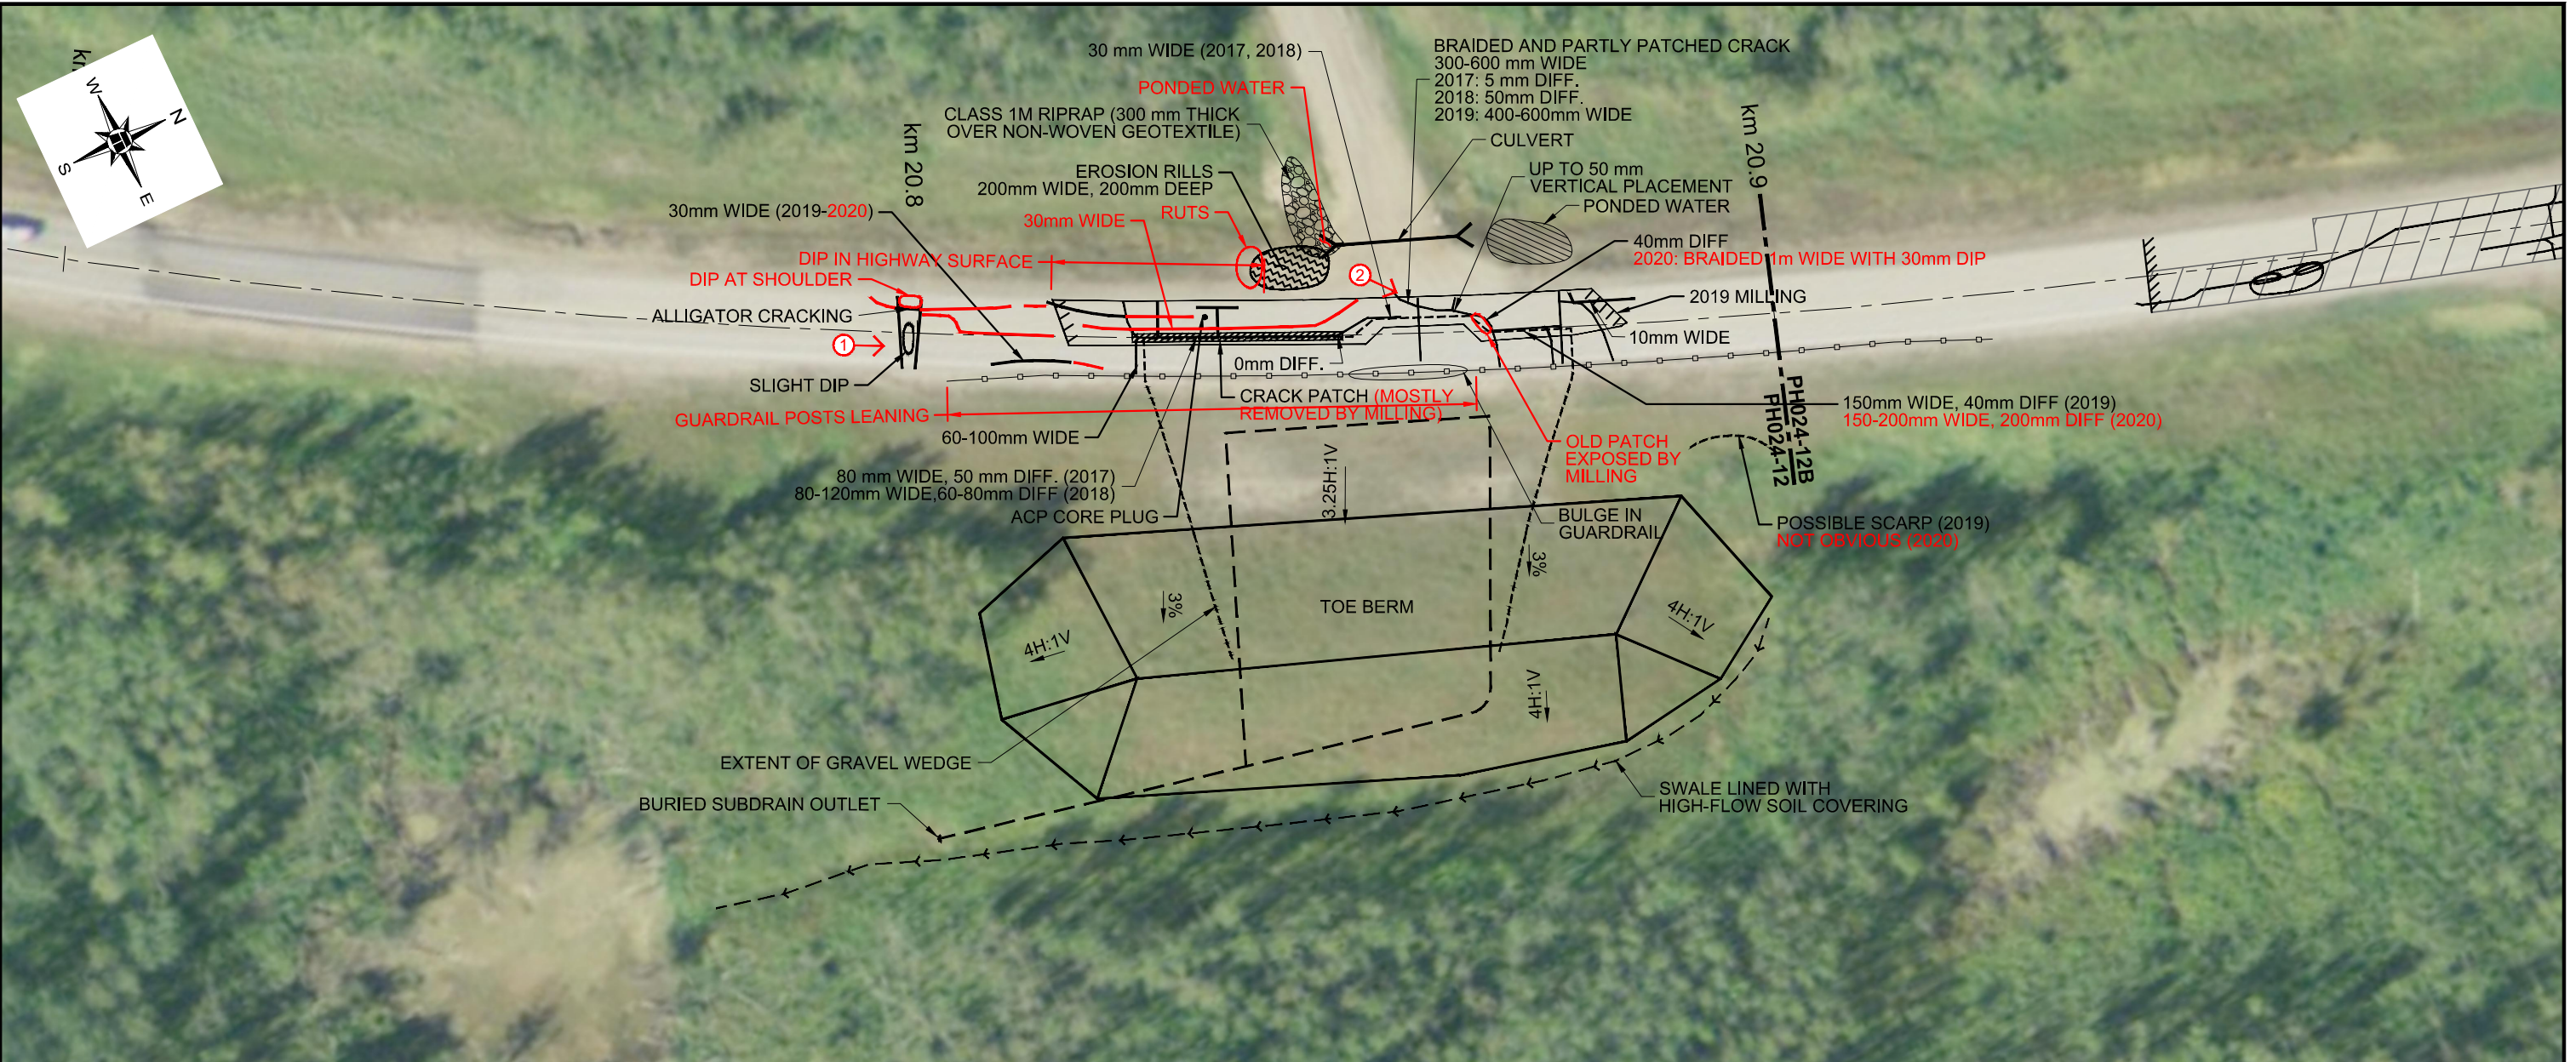


DETAILED SITE PLAN

SCALE 1:750

OVERALL SITE PLAN

SCALE 1:30 000

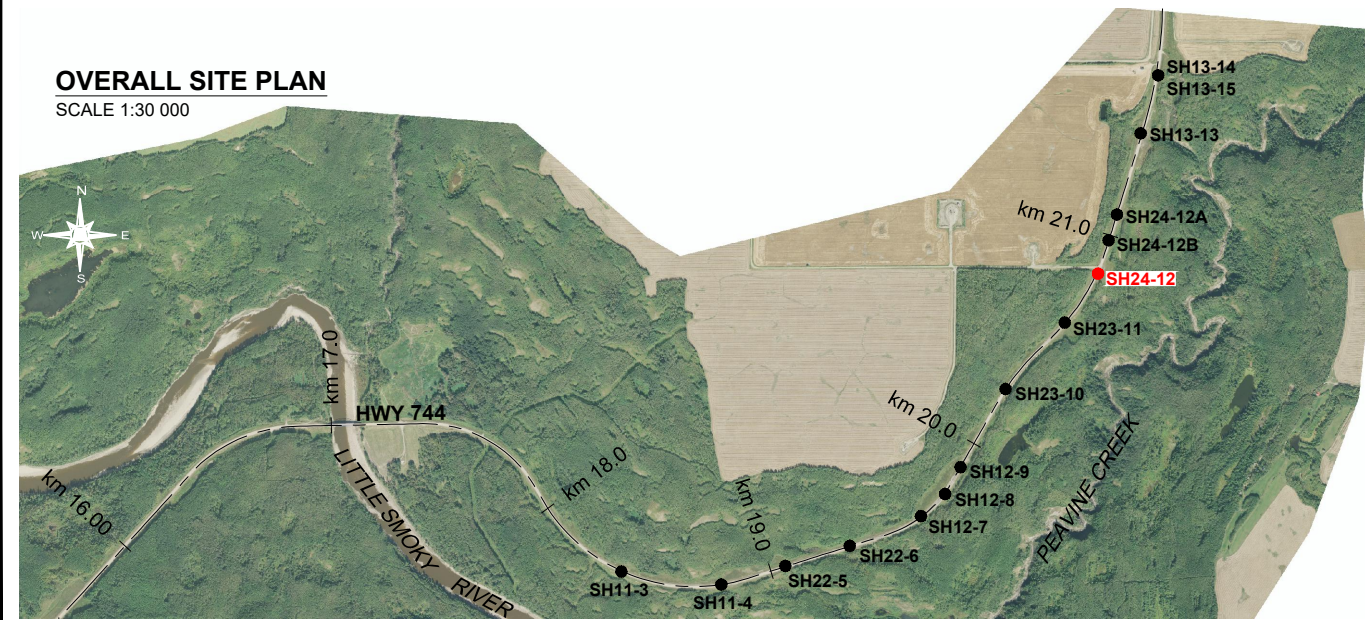


LEGEND

- CULVERT
- GUARDRAIL
- DIRECTION AND NUMBER OF PHOTO

NOTES

1. FEATURE LOCATIONS ARE APPROXIMATE.
2. PREVIOUS OBSERVATIONS SHOWN IN BLACK (2013-2015 FROM AMEC FIGURE 1, PROJECT EG10030, PROVIDED BY ALBERTA TRANSPORTATION).
3. JUNE 2020 OBSERVATIONS SHOWN IN RED.

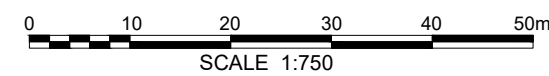

SATELLITE IMAGE FROM VALTUS IMAGERY (DATED 2014)



PEACE REGION (SWAN HILLS)


**SH024-12: HWY 744:02 LITTLE SMOKY RIVER VALLEY
2020 SITE INSPECTION PLAN**

DWG No. 13355-SH024-12

DRAWN BY	KLW
DESIGNED BY	KEF
APPROVED BY	DWP
SCALE	AS SHOWN
DATE	OCTOBER 2020
FILE No.	13355




H:\13000\13355 Geohazard Assessment - Swan Hills (CON0017604)\Drafting\2020\KEF\13355 SH024-12B.dwg - Layout1 - Oct. 23, 2020

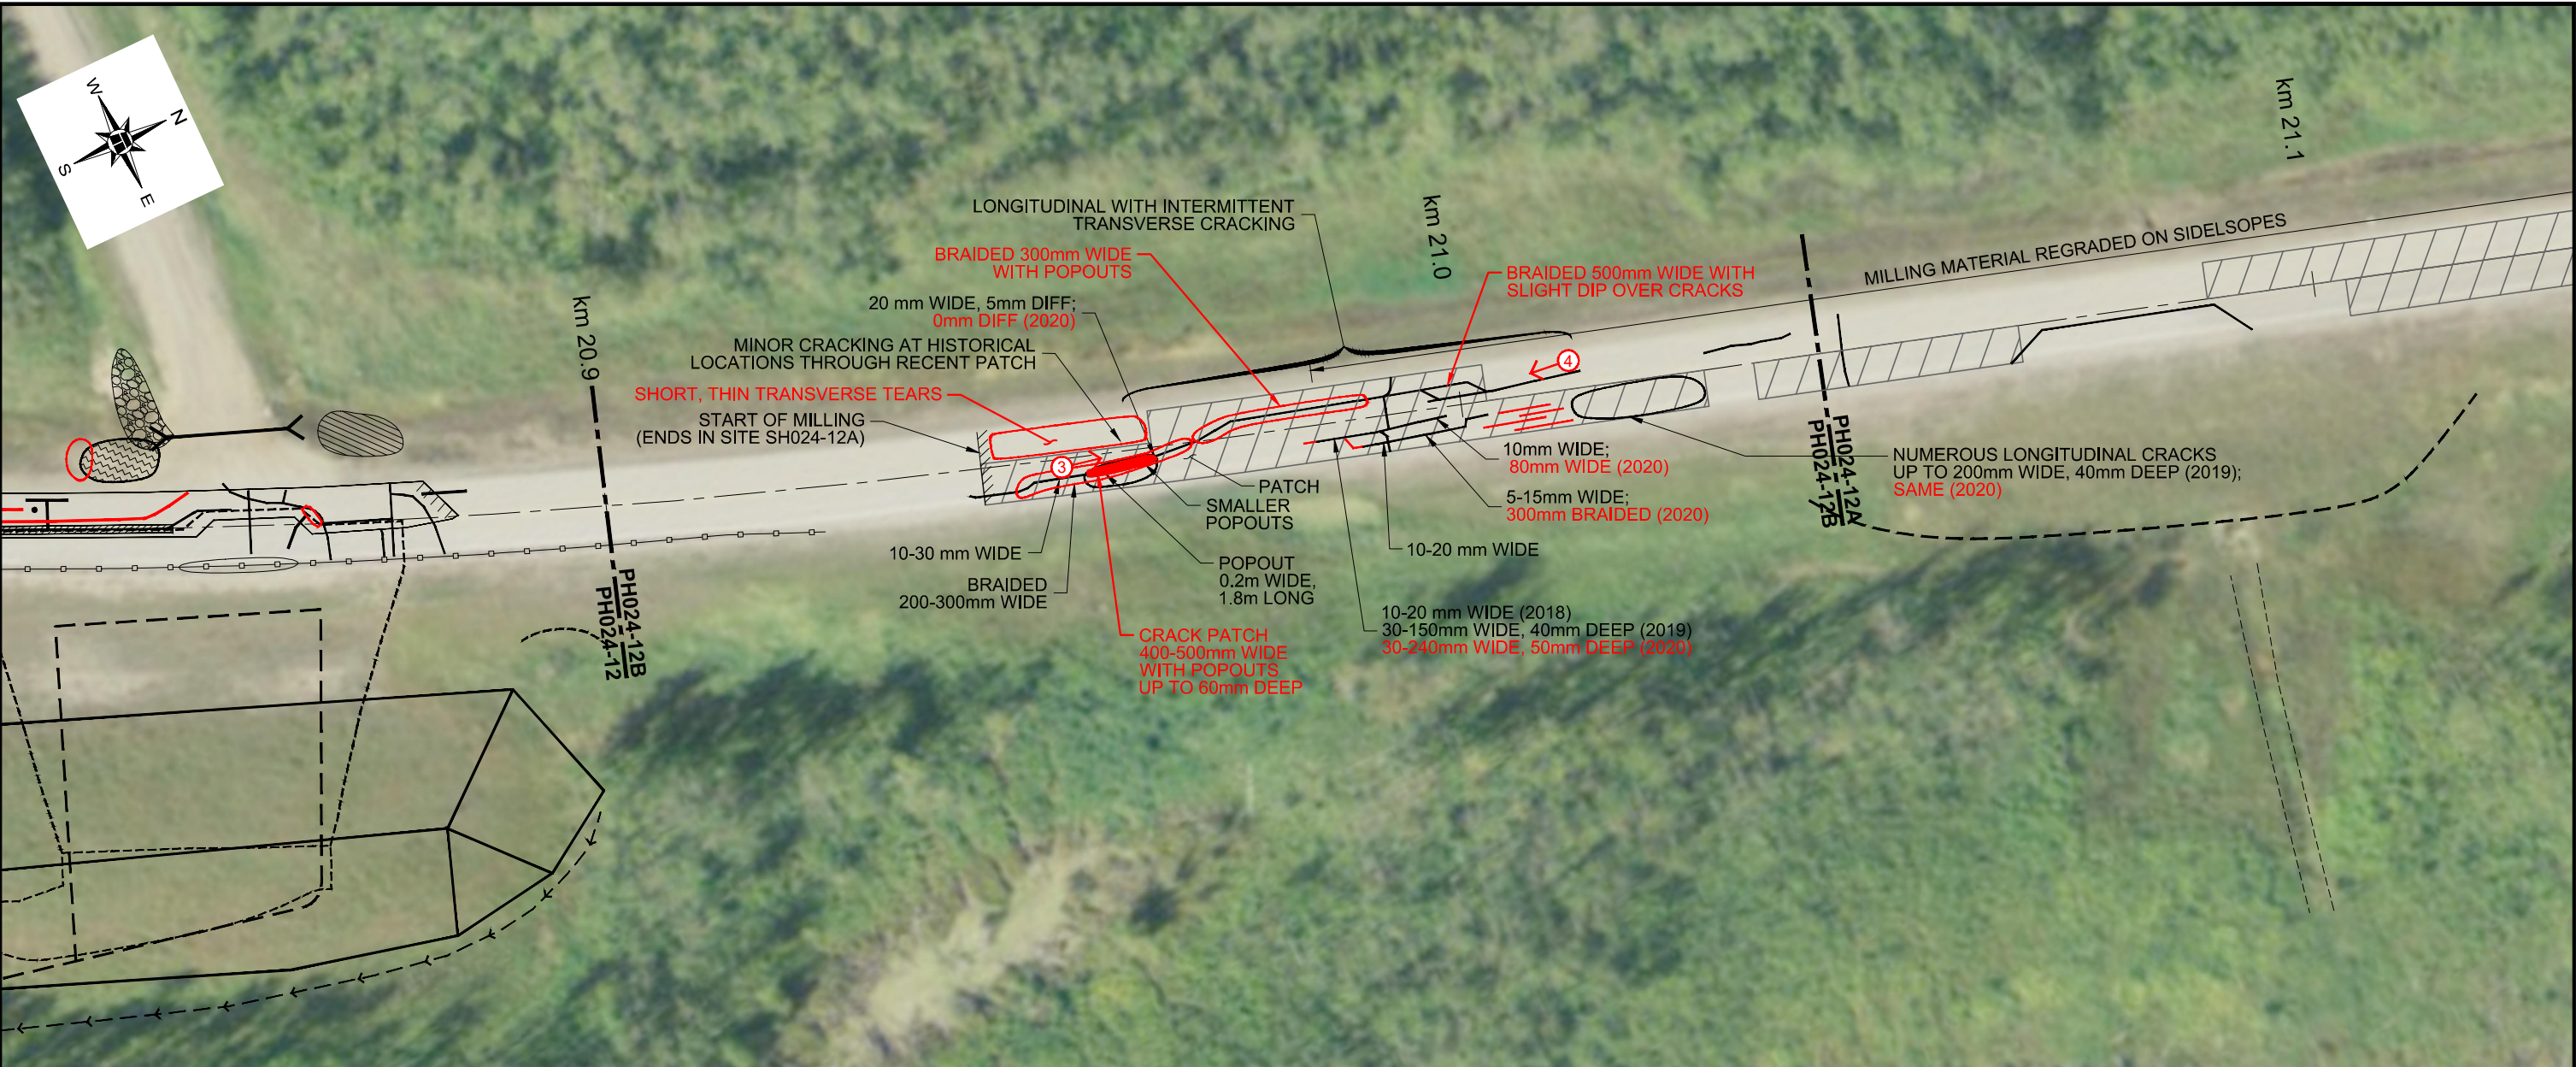

DETAILED SITE PLAN
SCALE 1:750

OVERALL SITE PLAN
SCALE 1:30 000

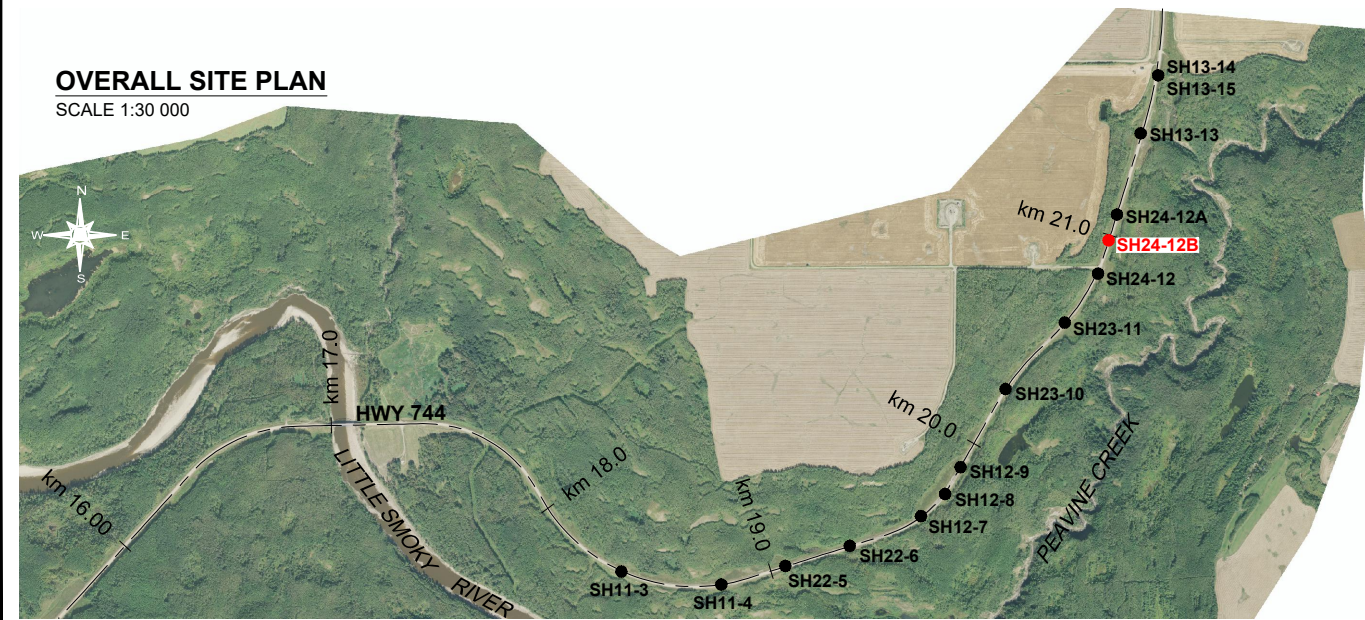

LEGEND

- CULVERT
- GUARDRAIL
- RED TEMPORARY HAZARD SIGN
- DIRECTION AND NUMBER OF PHOTO

NOTES

1. FEATURE LOCATIONS ARE APPROXIMATE.
2. PREVIOUS OBSERVATIONS SHOWN IN BLACK (2013-2015 FROM AMEC FIGURE 1, PROJECT EG10030, PROVIDED BY ALBERTA TRANSPORTATION).
3. JUNE 2020 OBSERVATIONS SHOWN IN RED.
4. PREVIOUSLY UNRECORDED CRACKS MAPPED AND ADDED IN 2018



SATELLITE IMAGE FROM VALTUS IMAGERY (DATED 2014)



PEACE REGION (SWAN HILLS)


**SH024-12B: HWY 744:02 LITTLE SMOKY RIVER VALLEY
2020 SITE INSPECTION PLAN**

DWG No. 13355-SH024-12B

DRAWN BY	KLW
DESIGNED BY	KEF
APPROVED BY	DWP
SCALE	AS SHOWN
DATE	OCTOBER 2020
FILE No.	13355



H:\13000\13355 Geohazard Assessment - Swan Hills (CON0017604)\Drafting\2020\KEF\13355 SH024-12A.dwg - Layout1 - Oct. 19, 2020

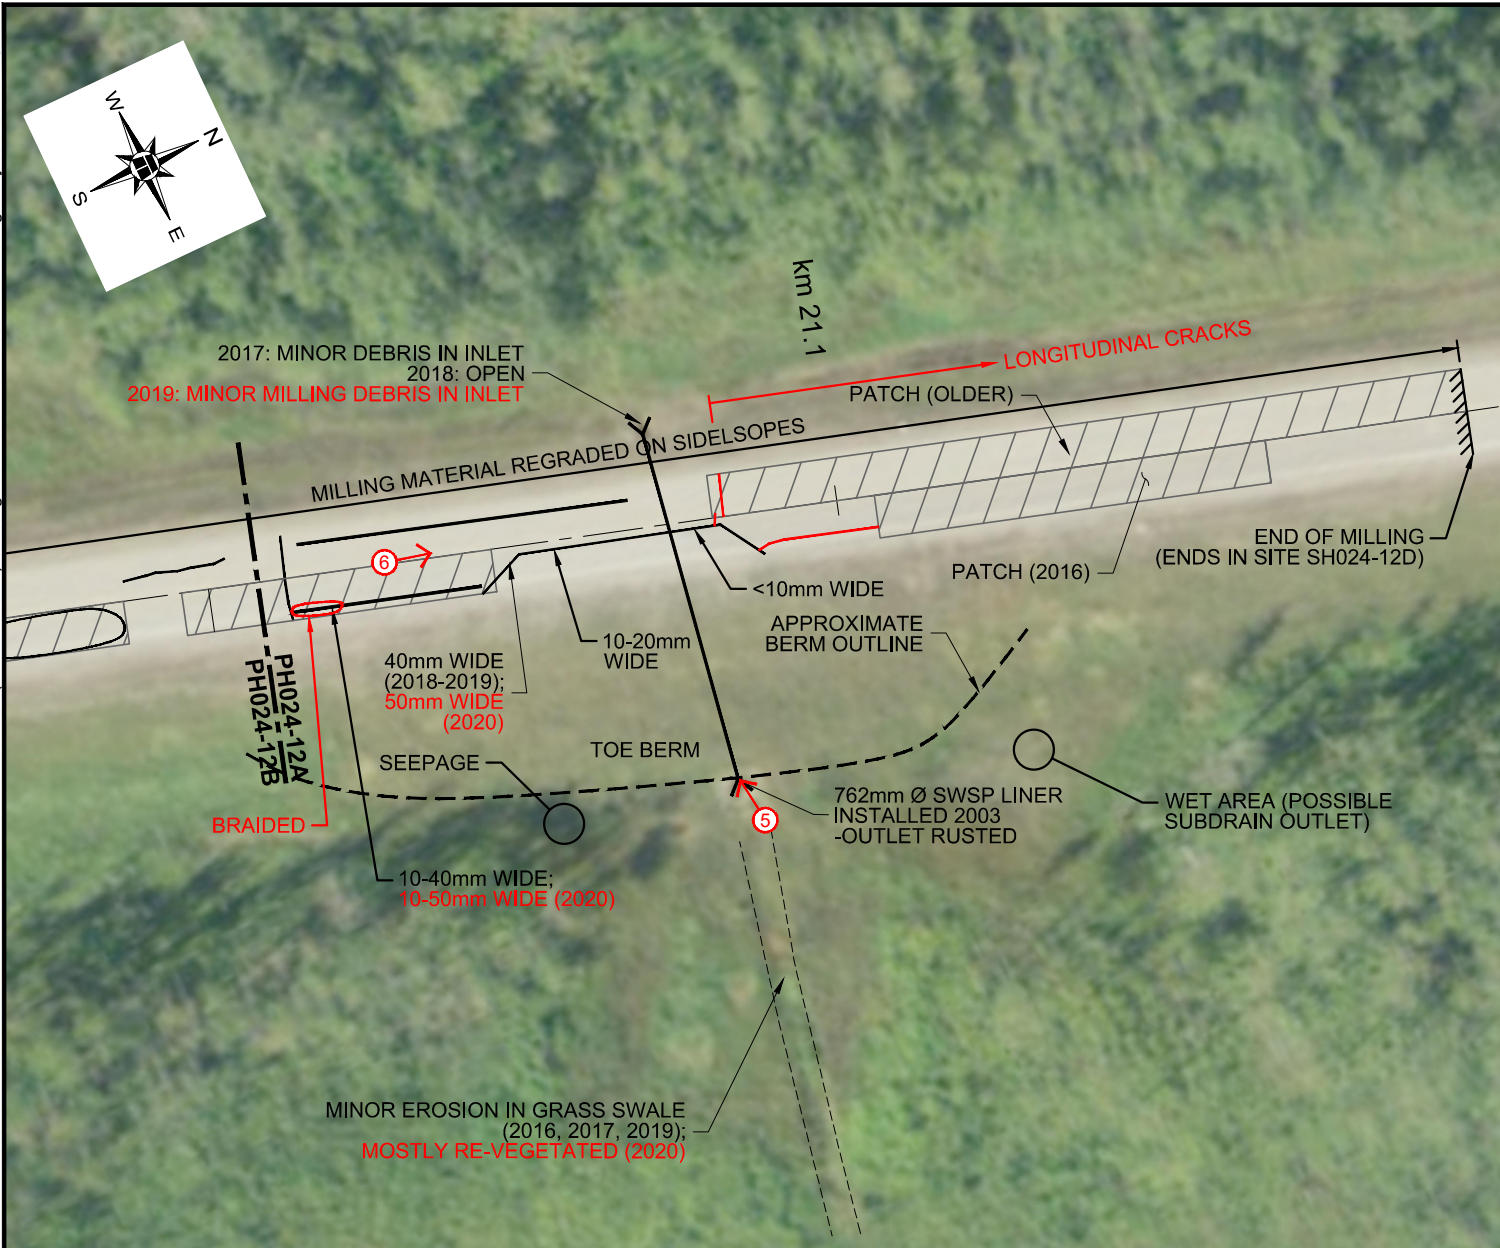


DETAILED SITE PLAN

SCALE 1:750


OVERALL SITE PLAN

SCALE 1:30 000

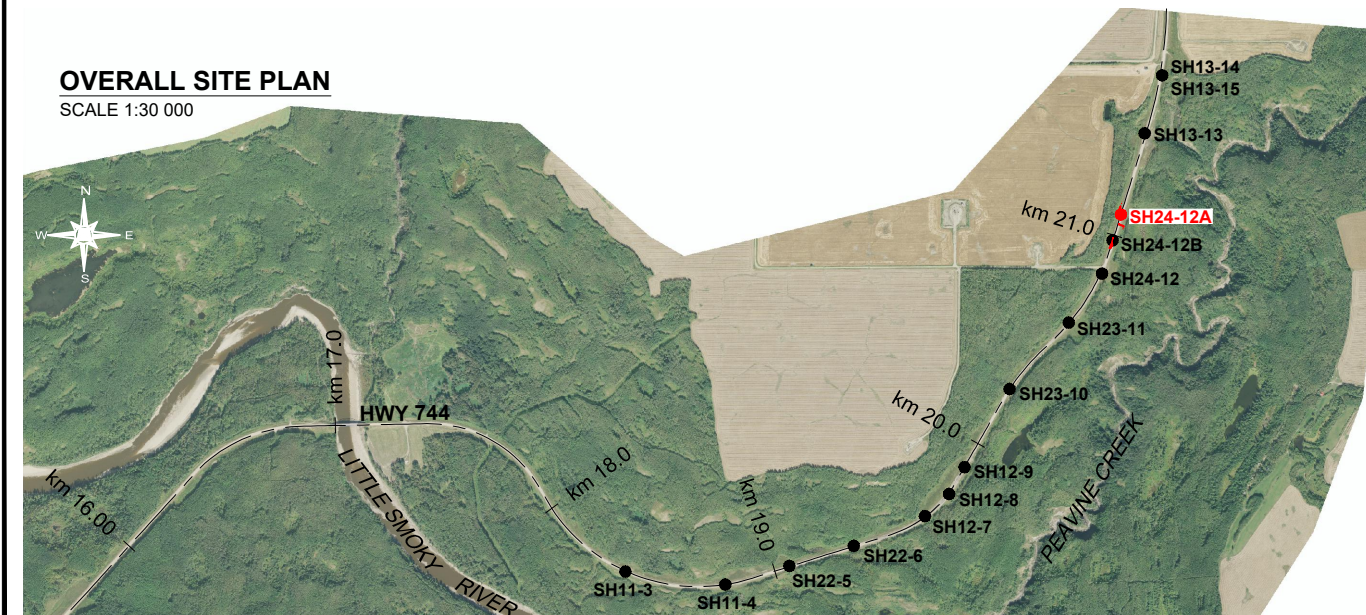

SCHEMATIC AS-BUILT PLAN

NTS

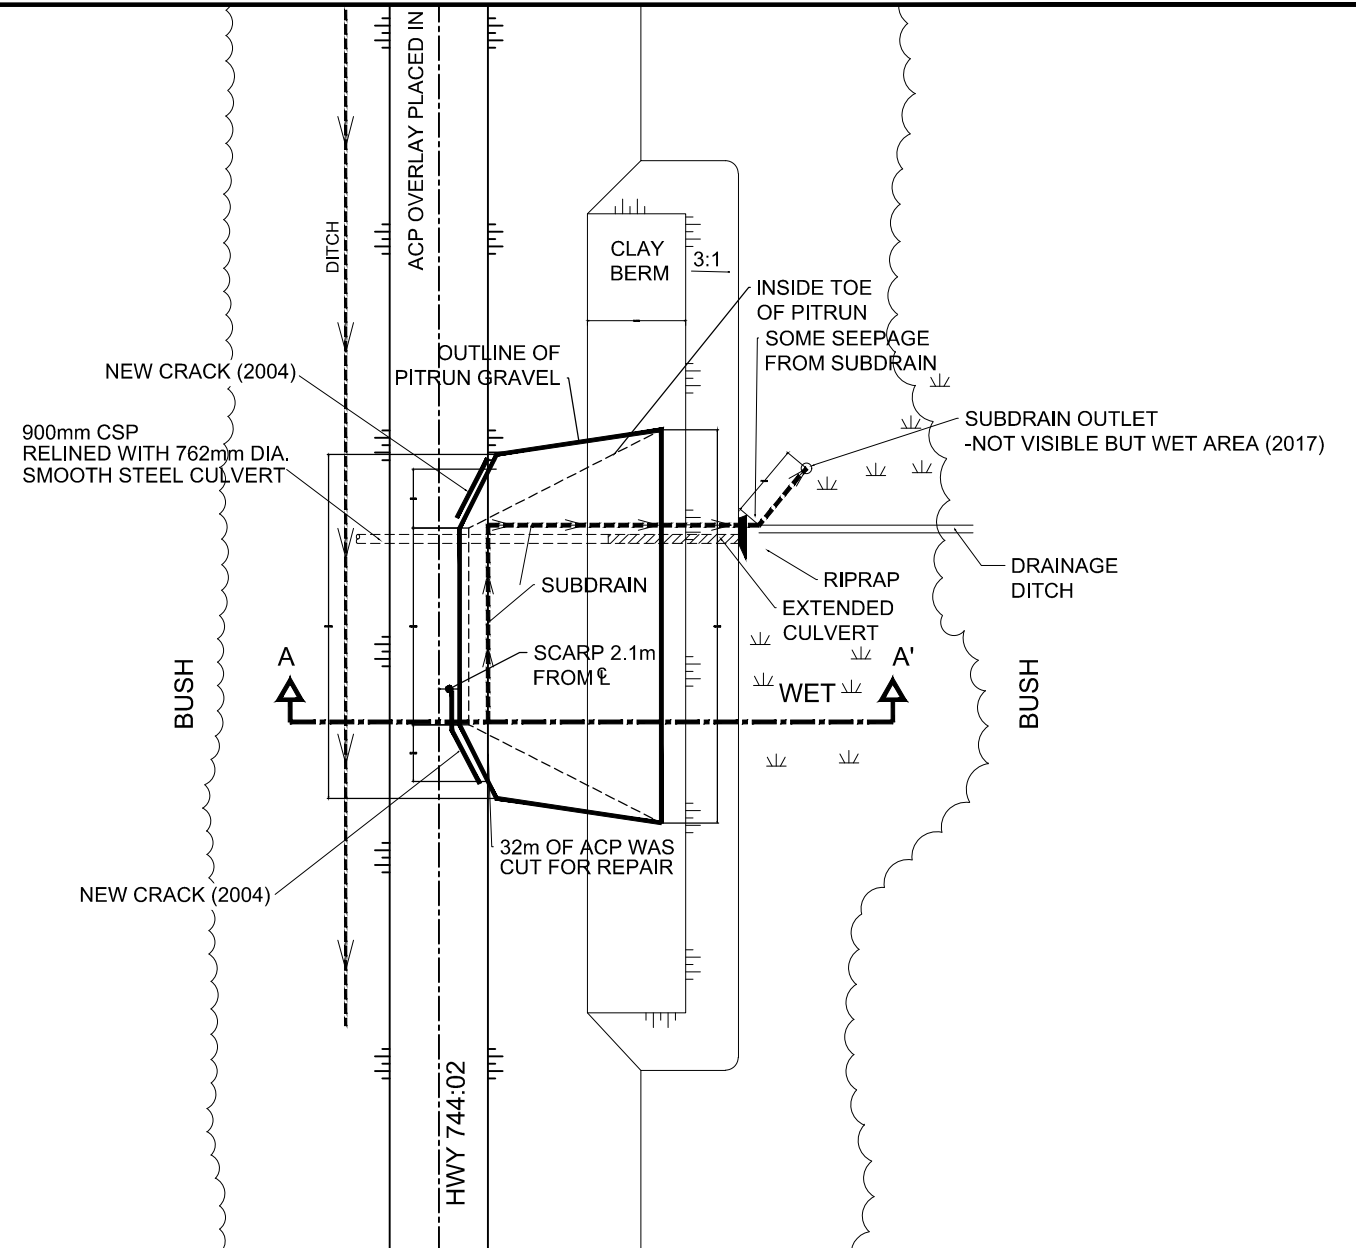

LEGEND

- CULVERT
- DIRECTION AND NUMBER OF PHOTO

NOTES

1. FEATURE LOCATIONS ARE APPROXIMATE.
2. PREVIOUS OBSERVATIONS SHOWN IN BLACK (2013-2015 FROM AMEC FIGURE 1, PROJECT EG10030, PROVIDED BY ALBERTA TRANSPORTATION).
3. JUNE 2020 OBSERVATIONS SHOWN IN RED.



SATELLITE IMAGE FROM VALTUS IMAGERY (DATED 2014)



PEACE REGION (SWAN HILLS)

**SH024-12A: HWY 744:02 LITTLE SMOKY RIVER VALLEY
2020 SITE INSPECTION PLAN**

DWG No. 13355-SH024-12A

DRAWN BY	KLW
DESIGNED BY	KEF
APPROVED BY	DWP
SCALE	AS SHOWN
DATE	OCTOBER 2020
FILE No.	13355





Photo 1, Site 12 – Looking northeast over toe berm. Note vertical and horizontal deformation of the guardrail.



Photo 2, Site 12 – Looking north from TR764 intersection at main scarp crack.



Photo 3, Site 12B: Looking north at deteriorating patch over crack at south end of site.



Photo 4, Site 12B – Looking south at main crack.



Photo 5, Site 12A – Rusting culvert liner outlet.



Photo 6, Site 12A – Looking north at crack forming along edge of toe berm excavation.