
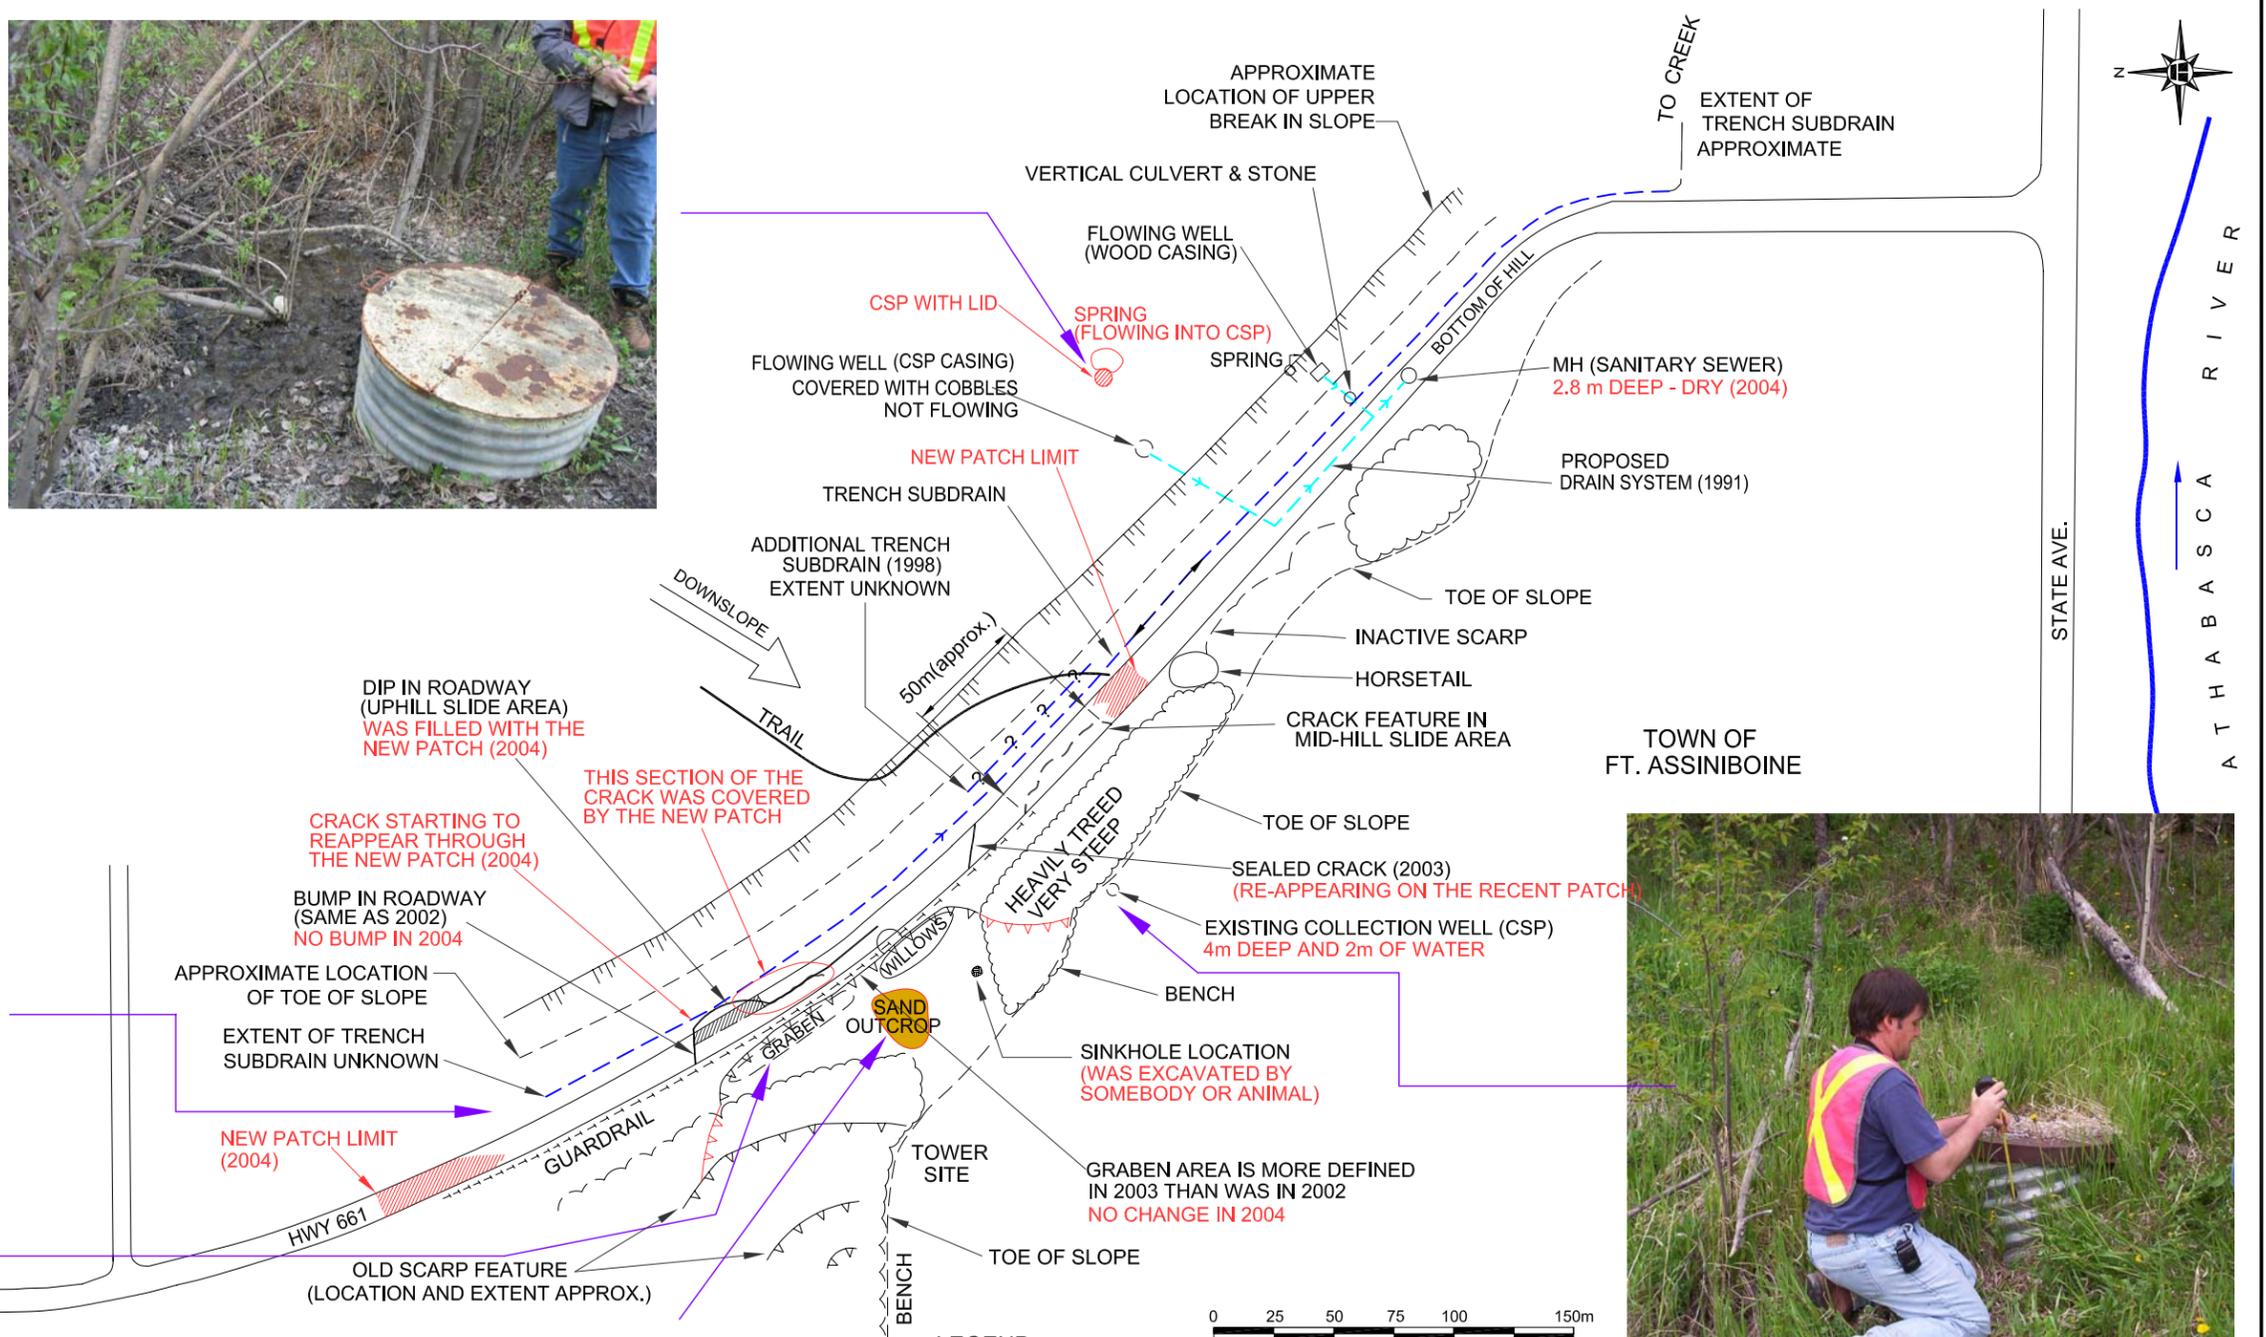


G:\ACAD\FILE15\15-16-192-2004-NORTH CENTRAL REGION\NC14\NC14-1.dwg-Oct. 27, 2004 3:19pm

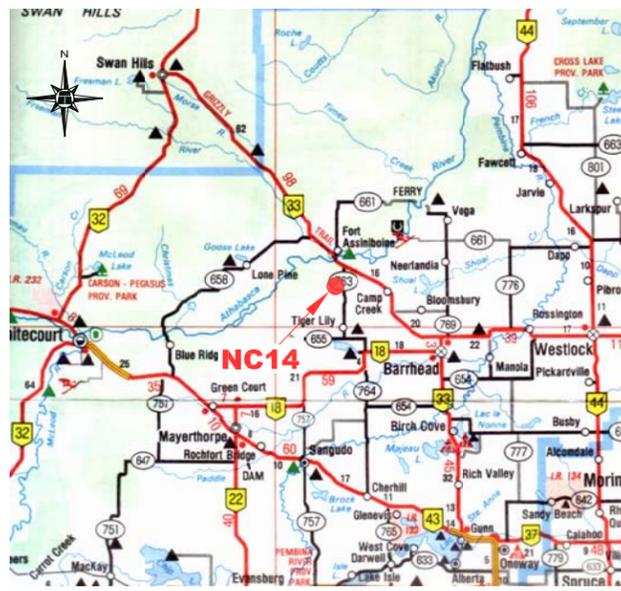

- NOTES:**
1. FEATURE LOCATIONS ARE APPROXIMATE.
 2. PREVIOUS OBSERVATIONS SHOWN IN BLACK
 3. JUNE 8, 2004 OBSERVATIONS SHOWN IN RED

ENGINEER	RVC
DRAWN	MNG
DATE	JULY 2004
APPROVED	
SCALE	1:3000 (APPROX.)

ALBERTA TRANSPORTATION

SITE PLAN

NORTH CENTRAL GEOHAZARD ASSESSMENT

NW-1-62-6-W5M
HWY 661:02 km1.8
N. OF FT. ASSINIBOINE

THURBER PROJECT #15-16-192



DRAWING No.
FIGURE NC14-1

